STATE OF VERMONT
AGENCY OF TRANSPORTATION

TRAFFIC SIGN SUMMARY SHEET 3 – FERRISBURGH

DIRECTION	MILEMARKER, STATION, OR SIGN NUMBER	LOCATION	MANUAL ON UNIFORM TRAFFIC DEVICES OR STATE CODE	SIGN DIMENSIONS WIDTH	SIGN DIMENSIONS HEIGHT	SHEETING REMARKS	SIGN LEGEND	NEW SIGNS "A"	NEW SIGNS "B"	EXISTING SIGNS RETAIN	EXISTING SIGNS SALVAGE FROM	EXISTING SIGNS SALVAGE TO	EXISTING SIGNS REMOVE	EXISTING POST RETAIN	EXISTING POST REMOVE	NO. OF NEW POSTS	SQUARE STEEL (in) 1.75 lb/ft 1.88	SQUARE STEEL (in) 2.00 lb/ft 2.42	SQUARE STEEL (in) 2.50 lb/ft 3.35	TUBULAR STEEL O/(in) FOUNDATION	TUBULAR STEEL O/(in) 3.00 lb/ft 7.60	TUBULAR STEEL O/(in) 3.50 lb/ft 9.00	TUBULAR STEEL O/(in) 4.00 lb/ft 10.80	TUBULAR STEEL O/(in) 5.00 lb/ft 14.60	SIGN FRAME REQUIRED	REMARKS SHS = STANDARD HIGHWAY SIGN BOOK	SIGN DETAIL DETAIL IN SHS	SIGN DETAIL DETAIL ON SHEET NUMBER	SIGN DETAIL STANDARD SHEET NUMBER
EB	MM 0.734, RT	A	W1-10 L	36	36			9.00								2		X								INSTALL NEW SIGN ON 2-POSTS 30 FT WEST OF POLE# 4762/3/18	X		
		A	W16-8P	30	8			1.67																		INSTALL BENEATH HORIZONTAL ALIGNMENT WARNING SIGN AT THE CORRECT SIGN HEIGHT		9	
EB	MM 0.781, RT	A	R2-5A	24	30								X		X											REMOVE SIGN AND POST			
WB	MM 0.734, RT	F	W2-1	30	30			6.25								2		X								INSTALL NEW SIGN ON 2-POSTS 143 FT WEST OF POLE# 2/95	X		
		F	W16-8AP	48	15			5.00																		INSTALL BENEATH INTERSECTION WARNING SIGN AT THE CORRECT SIGN HEIGHT		9	
EB	MM 0.912, RT	A/B	D3-1	36	12		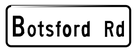	3.00					X													INSTALL SIGN ABOVE STOP WITH UPDATED DESIGN		9	
		D	R1-1	30	30			6.25					X		X	1		X								REMOVE SIGN AND POST AND INSTALL NEW SIGN AND POST AT SAME LOCATION	X		
WB	MM 0.913, LT	E/F	D3-1	36	12								X		X											REMOVE SIGN AND POST			
WB	MM 0.920, LT	E/F	D3-1	36	12			3.00																		INSTALL SIGN ABOVE STOP WITH UPDATED DESIGN		9	
		H	R1-1	30	30			6.25					X		X	1		X								REMOVE SIGN AND POST AND INSTALL NEW SIGN AND POST AT SAME LOCATION	X		
EB	MM 0.981, RT	A	W2-1	30	30			6.25								2		X								INSTALL NEW SIGN ON 2-POSTS 32 FT EAST OF POLE# 103801/2/2	X		
		A	W16-8AP	48	15			5.00																		INSTALL BENEATH INTERSECTION WARNING SIGN AT THE CORRECT SIGN HEIGHT		9	
WB	MM 1.553, LT	F	W2-2 L	30	30			6.25								1		X								INSTALL NEW SIGN AND POST 30 FT EAST OF POLE# 103812/13/13	X		
		F	W16-8P	30	8			1.67																		INSTALL BENEATH SIDE ROAD WARNING SIGN AT THE CORRECT SIGN HEIGHT		9	

FINAL POST LENGTHS ARE TO BE DETERMINED IN THE FIELD. POST SIZES ARE COMPUTED BASED ON INFORMATION FURNISHED ON THE STANDARD SHEETS AND THE VTRANS "SIGN POST DESIGN GUIDELINE".

										EA	EA	EA	EA	EA	EA		FT	FT	FT		LB	LB	LB	LB				
													5		4			135											
			SHEET SUBTOTALS					SF 59.59	SF	EA 5				EA ~~4~~		EA ~~9~~	FT 135			EA	LB								

PROJECT NAME: STATEWIDE NORTHWEST REGION
PROJECT NUMBER: STP HRRR(5)

FILE NAME: 10k018_wrk.dgn
PROJECT LEADER: JLS
DESIGNED BY: NLA
PLOT DATE: 14-SEP-2012 15:29
DRAWN BY: ITS
CHECKED BY: JLS