STATE OF VERMONT
AGENCY OF TRANSPORTATION

TRAFFIC SIGN SUMMARY SHEET 5 – FERRISBURGH

DIRECTION	MILEMARKER, STATION, OR SIGN NUMBER	LOCATION	MANUAL ON UNIFORM TRAFFIC DEVICES OR STATE CODE	SIGN DIMENSIONS WIDTH	SIGN DIMENSIONS HEIGHT	SHEETING REMARKS	SIGN LEGEND	NEW SIGNS "A"	NEW SIGNS "B"	EXISTING SIGNS RETAIN	EXISTING SIGNS SALVAGE FROM	EXISTING SIGNS SALVAGE TO	EXISTING SIGNS REMOVE	EXISTING POST RETAIN	EXISTING POST REMOVE	NO. OF NEW POSTS	SQUARE STEEL (in) 1.75 lb/ft 1.88	SQUARE STEEL (in) 2.00 lb/ft 2.42	SQUARE STEEL (in) 2.50 lb/ft 3.35	FOUNDATION	TUBULAR STEEL O/(in) 3.00 lb/ft 7.60	TUBULAR STEEL O/(in) 3.50 lb/ft 9.00	TUBULAR STEEL O/(in) 4.00 lb/ft 10.80	TUBULAR STEEL O/(in) 5.00 lb/ft 14.60	SIGN FRAME REQUIRED	REMARKS (SHS = STANDARD HIGHWAY SIGN BOOK)	SIGN DETAIL: DETAIL IN SHS	SIGN DETAIL: DETAIL ON SHEET NUMBER	SIGN DETAIL: STANDARD SHEET NUMBER
WB	MM 3.474, LT	F	W3-1	36	36		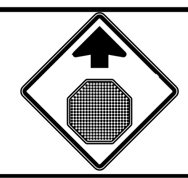	9.00								2		X								INSTALL NEW SIGN ON 2- POSTS 79 FT EAST OF AND ACROSS FROM POLE# 103849/42-50/2-13/42 1/2	X		
EB	MM 0.014, RT	A/B	D3-1	36	12		Sand Rd	2.50					X													INSTALL SIGN ABOVE STOP WITH UPDATED DESIGN		9	
		G/H	D3-1	54	12		Little Chicago Rd	4.50					X			2		X								INSTALL NEW SIGN ON 2-POSTS JUST RIGHT OF THE STOP SIGN		9	
		F	R1-1	30	30		STOP	6.25					X		X	1		X								REMOVE SIGN AND POST AND INSTALL NEW SIGN AND POST AT SAME LOCATION	X		
										EA	EA	EA	EA 3	EA	EA 1		FT	FT 75	FT		LB	LB	LB	LB					
							SHEET SUBTOTALS	SF 22.25	SF	EA 3				EA ~~1~~		EA ~~5~~	FT 75			EA	LB								

FINAL POST LENGTHS ARE TO BE DETERMINED IN THE FIELD. POST SIZES ARE COMPUTED BASED ON INFORMATION FURNISHED ON THE STANDARD SHEETS AND THE VTRANS "SIGN POST DESIGN GUIDELINE".

PROJECT NAME: STATEWIDE NORTHWEST REGION
PROJECT NUMBER: STP HRRR(5)

FILE NAME: 10k018_wrk.dgn
PROJECT LEADER: JLS
DESIGNED BY: NLA
FERRISBURGH TRAFFIC SIGN SUMMARY SHEET 5
PLOT DATE: 14-SEP-2012 15:29
DRAWN BY: ITS
CHECKED BY: JLS
SHEET 21 OF 51