STATE OF VERMONT
AGENCY OF TRANSPORTATION

TRAFFIC SIGN SUMMARY SHEET 1 - NORTHFIELD

DIRECTION	MILEMARKER, STATION, OR SIGN NUMBER	LOCATION	MANUAL ON UNIFORM TRAFFIC DEVICES OR STATE CODE	SIGN DIMENSIONS WIDTH	SIGN DIMENSIONS HEIGHT	SHEETING REMARKS	SIGN LEGEND	NEW SIGNS "A"	NEW SIGNS "B"	EXISTING SIGNS RETAIN	EXISTING SIGNS SALVAGE FROM	EXISTING SIGNS SALVAGE TO	EXISTING SIGNS REMOVE	EXISTING POST RETAIN	EXISTING POST REMOVE	NO. OF NEW POSTS	SQUARE STEEL (in) 1.75 lb/ft 1.88	SQUARE STEEL (in) 2.00 lb/ft 2.42	SQUARE STEEL (in) 2.50 lb/ft 3.35	TUBULAR STEEL O/(in) FOUNDATION	TUBULAR STEEL O/(in) 3.00 lb/ft 7.60	TUBULAR STEEL O/(in) 3.50 lb/ft 9.00	TUBULAR STEEL O/(in) 4.00 lb/ft 10.80	TUBULAR STEEL O/(in) 5.00 lb/ft 14.60	SIGN FRAME REQUIRED	REMARKS SHS = STANDARD HIGHWAY SIGN BOOK	SIGN DETAIL DETAIL IN SHS	SIGN DETAIL DETAIL ON SHEET NUMBER	SIGN DETAIL STANDARD SHEET NUMBER
NB	MM 0.000, RT	A	WI-2R	30	30			6.25								1		X								INSTALL NEW SIGN AND POST ACROSS FROM POLE #29	X		
NB	MM 0.0295, RT	A	VW-054	30	30			6.25								1		X								INSTALL NEW SIGN AND POST 182 FT SOUTH OF THE CENTER OF THE DRIVE AT HOUSE# 552 UNION BROOK RD		8	
SB	MM 0.030, LT	H	RI-1	30	30			6.25					X		X	1		X								REMOVE SIGN AND POST AND INSTALL NEW SIGN AND POST AT SAME LOCATION	X		
SB	MM 0.039, LT	F	D3-1	54	12			4.50					X		X	2		X								INSTALL NEW SIGN ON 2-POSTS 48 FT SOUTH OF STOP SIGN ACROSS THE ROAD HOCKMAN HILL ROAD		8	
NB	MM 0.039, RT	A	VW-054	30	30								X		X											REMOVE SIGN AND POST			
SB	MM 0.043, LT	E	WI-8 R	18	24			3.00								1		X								INSTALL NEW CHEVRONS BACK-TO-BACK ON SIGN BRACKET AND SINGLE POST 58 FT NORTH FROM THE CENTER OF HOCKMAN HILL RD	X		
		F	WI-8 L	18	24			3.00																			X		
SB	MM 0.053, LT	E	WI-8 R	12	18								X		X											REMOVE SIGN AND POSTS			
		F	WI-8 L	12	18								X		X														
SB	MM 0.058, LT	E	WI-8 R	18	24			3.00								1		X								INSTALL NEW CHEVRONS BACK-TO-BACK ON SIGN BRACKET ON A SINGLE POST 80 FT NORTH OF NEW CHEVRON AT MM 0.043	X		
		F	WI-8 L	18	24			3.00																			X		
SB	MM 0.063, LT	E	WI-8 R	12	18		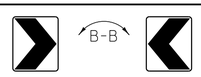						X		X											REMOVE SIGN AND POST			
		F	WI-8 L	12	18								X		X														
SB	MM 0.073, LT	E	WI-8 R	18	24			3.00					X		X	1		X								INSTALL NEW CHEVRONS BACK-TO-BACK ON SIGN BRACKET AND A SINGLE POST 80 FT NORTH OF NEW CHEVRON AT MM 0.058.	X		
		F	WI-8 L	18	24			3.00					X		X													X		
SB	MM 0.083, LT	F	S3-1	30	30	F-Y-G		6.25					X		X	1		X								INSTALL NEW SIGN AT EXISTING LOCATION 68 FT SOUTH OF POLE# 31	X		
NB	MM 0.095, RT	F	R2-1	24	30			5.00					X		X	1		X								INSTALL NEW SIGN AND POST 5 FT SOUTH OF POLE# 31	X		
SB	MM 0.098, LT	A	WI-2	30	30								X		X											REMOVE SIGN AND POST			
SB	MM 0.098, LT	F	WI-10L	36	36			9.00								2		X								INSTALL NEW SIGN ON 2-POSTS 10 FT NORTH OF POLE# 31	X		
SB		F	W16-8P	42	8			2.33																		INSTALL BENEATH HORIZONTAL ALIGNMENT WITH SIDE ROAD WARNING SIGN AT CORRECT SIGN HEIGHT		8	
								EA		EA	EA	EA	EA	EA	EA		FT	FT	FT		LB	LB	LB	LB					
													12		9			180											
							SHEET SUBTOTALS	SF 63.83	SF	EA 12				EA ~~9~~		EA ~~12~~	FT 180			EA	LB								

FINAL POST LENGTHS ARE TO BE DETERMINED IN THE FIELD. POST SIZES ARE COMPUTED BASED ON INFORMATION FURNISHED ON THE STANDARD SHEETS AND THE VTRANS "SIGN POST DESIGN GUIDELINE".

PROJECT NAME: STATEWIDE NORTHWEST REGION
PROJECT NUMBER: STP HRRR(5)

FILE NAME: 10k018_wrk.dgn
PROJECT LEADER: JLS
DESIGNED BY: NLA
PLOT DATE: 14-SEP-2012 15:29
DRAWN BY: ITS
CHECKED BY: JLS
NORTHFIELD TRAFFIC SIGN SUMMARY SHEET 1 SHEET 27 OF 51