STATE OF VERMONT
AGENCY OF TRANSPORTATION

TRAFFIC SIGN SUMMARY SHEET 6 – RICHMOND

DIRECTION	MILEMARKER, STATION, OR SIGN NUMBER	LOCATION	MANUAL ON UNIFORM TRAFFIC DEVICES OR STATE CODE	SIGN DIMENSIONS WIDTH	SIGN DIMENSIONS HEIGHT	SHEETING REMARKS	SIGN LEGEND	NEW SIGNS "A"	NEW SIGNS "B"	EXISTING SIGNS RETAIN	EXISTING SIGNS SALVAGE FROM	EXISTING SIGNS SALVAGE TO	EXISTING SIGNS REMOVE	EXISTING POST RETAIN	EXISTING POST REMOVE	NO. OF NEW POSTS	SQUARE STEEL (in) 1.75 lb/ft 1.88	SQUARE STEEL (in) 2.00 lb/ft 2.42	SQUARE STEEL (in) 2.50 lb/ft 3.35	TUBULAR STEEL O/(in) FOUNDATION	TUBULAR STEEL O/(in) 3.00 lb/ft 7.60	TUBULAR STEEL O/(in) 3.50 lb/ft 9.00	TUBULAR STEEL O/(in) 4.00 lb/ft 10.80	TUBULAR STEEL O/(in) 5.00 lb/ft 14.60	SIGN FRAME REQUIRED	REMARKS SHS = STANDARD HIGHWAY SIGN BOOK	SIGN DETAIL: DETAIL IN SHS	SIGN DETAIL: DETAIL ON SHEET NUMBER	SIGN DETAIL: STANDARD SHEET NUMBER
SB	MM 1.560, LT	F	W2-2	30	30			6.25								1		X								INSTALL NEW SIGN AND POST 258 FT NORTH OF THE CENTER OF LAWRENCE RD 25 FT NORTH OF POLE# 60-6	X		
		F	W16-8P	30	8			1.67																		INSTALL NEW SIGN BENEATH SIDE ROAD INTERSECTION WARNING SIGN AT THE CORRECT HEIGHT		10	
SB	MM 1.616, LT	H	R1-1	30	30			6.25					X		X	1		X								REMOVE STOP SIGN AND POST AND INSTALL NEW SIGN AND POST AT SAME LOCATION (LAWRENCE RD)	X		
		E/F	D3-1	42	12			3.50					X													INSTALL NEW SIGN ABOVE HUNTINGTON ROAD STREET NAME SIGN ON THE SAME POST		10	
		G/H	D3-1	48	12			4.00																		INSTALL NEW SIGN ABOVE THE STOP SIGN AND BELOW THE LAWRENCE ST STREET NAME SIGN ON THE SAME POST		10	
SB	MM 1.637, LT	F	R2-1	24	30			5.00								1		X								INSTALL NEW SIGN AND POST 150 FT SOUTH OF THE CENTER OF LAWRENCE RD	X		
NB	MM 1.646, RT	A	W2-2	30	30			6.25								1		X								INSTALL NEW SIGN AND POST 200 FT SOUTH OF AND ACROSS FROM THE CENTER OF LAWRENCE RD	X		
		A	W16-8P	30	8			1.67																		INSTALL NEW SIGN BENEATH SIDE ROAD INTERSECTION WARNING SIGN AT THE CORRECT SIGN HEIGHT		10	
NB	MM 1.818, RT	A	W2-2L	30	30			6.25								1		X								INSTALL NEW SIGN AND POST AT POLE# 111589	X		
		A	W16-8P	24	8			1.33																		INSTALL NEW SIGN BENEATH SIDE ROAD INTERSECTION WARNING SIGN AT THE CORRECT SIGN HEIGHT		10	
NB	MM 1.836, RT	A	W2-2L	30	30								X		X											REMOVE SIGN AND POST			
NB	MM 1.854, RT	A	R2-1	24	30			5.00								1		X								INSTALL NEW SIGN AND POST 168 FT NORTH OF THE CENTER OF LAWRENCE RD	X		
NB	MM 1.864, RT	A	R2-1	24	30								X		X											REMOVE SIGN AND POST			
NB	MM 1.878, RT	D	R1-1	30	30			6.25					X		X	1		X								REMOVE STOP SIGN AND POST AND INSTALL NEW SIGN AND POST AT SAME LOCATION (BESAW RD)	X		
		A/B	D3-1	30	12		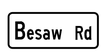	2.50					X													INSTALL NEW SIGN ABOVE THE STOP SIGN ON THE SAME POST		10	
SB	MM 1.911, LT	F	R2-1	24	30			5.00								1		X								INSTALL NEW SIGN AND POST 132 FT SOUTH OF THE CENTER OF BESAW RD	X		
																EA 6				EA 4			FT 120				LB						
							SHEET SUBTOTALS	SF 60.92	SF							EA 6				EA ~~4~~		EA ~~8~~	FT 120			EA	LB					

FINAL POST LENGTHS ARE TO BE DETERMINED IN THE FIELD. POST SIZES ARE COMPUTED BASED ON INFORMATION FURNISHED ON THE STANDARD SHEETS AND THE VTRANS "SIGN POST DESIGN GUIDELINE".

PROJECT NAME: STATEWIDE NORTHWEST REGION
PROJECT NUMBER: STP HRRR(5)

FILE NAME: 10k018_wrk.dgn
PROJECT LEADER: JLS
DESIGNED BY: NLA
RICHMOND TRAFFIC SIGN SUMMARY SHEET 6
PLOT DATE: 14-SEP-2012 15:30
DRAWN BY: ITS
CHECKED BY: JLS
SHEET 35 OF 51