STATE OF VERMONT
AGENCY OF TRANSPORTATION

TRAFFIC SIGN SUMMARY SHEET 7 - RICHMOND

DIRECTION	MILEMARKER, STATION, OR SIGN NUMBER	LOCATION	MANUAL ON UNIFORM TRAFFIC DEVICES OR STATE CODE	SIGN DIMENSIONS WIDTH	SIGN DIMENSIONS HEIGHT	SHEETING REMARKS	SIGN LEGEND	NEW SIGNS "A"	NEW SIGNS "B"	EXISTING SIGNS RETAIN	EXISTING SIGNS SALVAGE FROM	EXISTING SIGNS SALVAGE TO	EXISTING SIGNS REMOVE	EXISTING POST RETAIN	EXISTING POST REMOVE	NO. OF NEW POSTS	SQUARE STEEL (in) 1.75 lb/ft 1.88	SQUARE STEEL (in) 2.00 lb/ft 2.42	SQUARE STEEL (in) 2.50 lb/ft 3.35	TUBULAR STEEL O/(in) FOUNDATION	TUBULAR STEEL O/(in) 3.00 lb/ft 7.60	TUBULAR STEEL O/(in) 3.50 lb/ft 9.00	TUBULAR STEEL O/(in) 4.00 lb/ft 10.80	TUBULAR STEEL O/(in) 5.00 lb/ft 14.60	SIGN FRAME REQUIRED	REMARKS SHS = STANDARD HIGHWAY SIGN BOOK	SIGN DETAIL DETAIL IN SHS	SIGN DETAIL DETAIL ON SHEET NUMBER	SIGN DETAIL STANDARD SHEET NUMBER
NB	MM 1.931, RT	A	W2-2R	30	30			6.25								1		X								INSTALL NEW SIGN AND POST 238 FT SOUTH OF THE CENTER OF BESAW RD	X		
		A	W16-8P	24	8		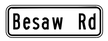	1.33																			INSTALL NEW SIGN BENEATH SIDE ROAD INTERSECTION WARNING SIGN AT THE CORRECT SIGN HEIGHT		10	
NB	MM 2.033, RT	D	R1-1	30	30			6.25					X		X	1		X								REMOVE STOP SIGN AND POST AND INSTALL NEW SIGN AND POST AT SAME LOCATION (GRANDVIEW DR)	X		
NB	MM 2.041, RT	A/B	D3-1	42	12		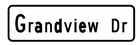	3.50					X		X											INSTALL NEW SIGN ABOVE STOP SIGN ON THE SAME POST		10	
NB	MM 2.071, RT	A	W7-1	30	30			6.25					X		X	1		X								INSTALL NEW SIGN AND POST OPPOSITE POLE# 1875	X		
SB	MM 2.186, LT	F	R2-1	24	30			5.00								1		X								INSTALL NEW SIGN AND POST 180 FT SOUTH OF THE CENTER OF GRANDVIEW DR	X		
SB	MM 2.530, LT	F	W1-2	30	30			6.25								1		X								INSTALL NEW SIGN AND POST 25 FT NORTH OF POLE# 56-50/32	X		
SB	MM 2.610, LT TO MM 2.550, LT	F E		6	8		(10) TYPE II - 6" X 8" WHITE DELINEATORS	3.33								5	X									INSTALL 5 DELINEATORS BACK-TO-BACK (10 TOTAL) 70 FT APART GOING NORTH. INSTALL THE FIRST ONE 60 FT NORTH OF POLE# 57-50/34		7	
NB	MM 2.977, RT	A	R2-1	24	30			5.00					X		X	1		X								INSTALL NEW SIGN AND POST NEXT TO BOX# 2683	X		
SB	MM 2.984, LT	F	R2-1	24	30			5.00					X		X	1		X								INSTALL NEW SIGN AND POST AT BOX# 2881	X		
NB	MM 3.193, RT	A	R2-1	24	30			5.00					X		X	1		X								INSTALL NEW SIGN AND POST 770 FT NORTH OF THE CENTER OF HILLVIEW RD	X		
SB	MM 3.277, LT	F	W10-1L	36	36			9.00					X		X	2		X								INSTALL NEW CURVE/INTERSECTION SIGN ON 2-POSTS 315 FT NORTH OF THE CENTER OF HILLVIEW RD	X		
		F	W16-8P	30	8			1.67																			INSTALL BENEATH THE CURVE/INTERSECTION WARNING SIGN AT THE CORRECT SIGN HEIGHT		10	
SB	MM 3.304, LT	F E	W1-8 L W1-8 R	18 18	24 24			3.00 3.00								1		X								INSTALL NEW CHEVRONS BACK-TO-BACK ON A SIGN BRACKET ON A SINGLE POST SPACED AT 120 FT APART GOING SOUTH. INSTALL THE FIRST ASSEMBLY 120 FT NORTH OF POLE# 77/755	X X		
SB	MM 3.327, LT	F E	W1-8 L W1-8 R	18 18	24 24			3.00 3.00								1		X								INSTALL NEW CHEVRONS BACK-TO-BACK ON A SIGN BRACKET ON A SINGLE POST ADJACENT TO POLE# 77/755	X X		
										EA	EA	EA	EA 7	EA	EA 7		FT 40	FT 180	FT 0							LB	LB	LB	LB
							SHEET SUBTOTALS	SF 75.83	SF	EA 7				EA ~~7~~		EA ~~17~~	FT 220			EA	LB						

FINAL POST LENGTHS ARE TO BE DETERMINED IN THE FIELD. POST SIZES ARE COMPUTED BASED ON INFORMATION FURNISHED ON THE STANDARD SHEETS AND THE VTRANS "SIGN POST DESIGN GUIDELINE".

PROJECT NAME: STATEWIDE NORTHWEST REGION
PROJECT NUMBER: STP HRRR(5)

FILE NAME: 10k018_wrk.dgn
PROJECT LEADER: JLS
DESIGNED BY: NLA
RICHMOND TRAFFIC SIGN SUMMARY SHEET 7
PLOT DATE: 14-SEP-2012 15:30
DRAWN BY: ITS
CHECKED BY: JLS
SHEET 36 OF 51