STATE OF VERMONT
AGENCY OF TRANSPORTATION

TRAFFIC SIGN SUMMARY SHEET 1 - NEW HAVEN

DIRECTION	MILEMARKER, STATION, OR SIGN NUMBER	LOCATION	MANUAL ON UNIFORM TRAFFIC DEVICES OR STATE CODE	SIGN DIMENSIONS WIDTH	SIGN DIMENSIONS HEIGHT	SHEETING REMARKS	SIGN LEGEND	NEW SIGNS "A"	NEW SIGNS "B"	EXISTING SIGNS RETAIN	EXISTING SIGNS SALVAGE FROM	EXISTING SIGNS SALVAGE TO	EXISTING SIGNS REMOVE	EXISTING POST RETAIN	EXISTING POST REMOVE	NO. OF NEW POSTS	SQUARE STEEL (in) 1.75 lb/ft 1.88	SQUARE STEEL (in) 2.00 lb/ft 2.42	SQUARE STEEL (in) 2.50 lb/ft 3.35	TUBULAR STEEL O/(in) FOUNDATION	TUBULAR STEEL O/(in) 3.00 lb/ft 7.60	TUBULAR STEEL O/(in) 3.50 lb/ft 9.00	TUBULAR STEEL O/(in) 4.00 lb/ft 10.80	TUBULAR STEEL O/(in) 5.00 lb/ft 14.60	SIGN FRAME REQUIRED	REMARKS SHS = STANDARD HIGHWAY SIGN BOOK	SIGN DETAIL DETAIL IN SHS	SIGN DETAIL DETAIL ON SHEET NUMBER	SIGN DETAIL STANDARD SHEET NUMBER
NB	MM 0.016, RT	B	OM3-L	12	36					X				X												RETAIN SIGN AND POST			
SB	MM 0.016, LT	F	TOWN SIGN	30	36								X		X											REMOVE SIGN AND POST			
		F	OM3-R	12	30					X					X	I		X							RETAIN SIGN SIDE UP TO CORRECT HEIGHT			
SB	MM 0.016, LT	F	WI-8 L	18	24								X		X											REMOVE SIGN AND POST			
		F	VR-017	24	30			5.00								I		X							INSTALL NEW SIGN AND POST AT THE SAME LOCATION AS REVIOUSLY REMOVED CHEVRON SIGN ASSEMBLY		7	
SB	MM 0.021, LT TO MM 0.080, LT	E/F		6	8		(20) TYPE II - 6" X 8" WHITE DELINEATORS	6.67								10	X									INSTALLED BACK-TO-BACK AT 35 FT± SPACING BEGINNING 26 FT NORTH OF LEFT BRIDGE CORNER TYPE 3 OBJECT MARKER BLOCKING OFF PULL-OFF AND D.I.		7	
NB	MM 0.020, RT TO MM 0.041, RT	A/B		6	8		(8) TYPE II - 6" X 8" WHITE DELINEATORS	2.67								4	X									INSTALLED BACK-TO-BACK AT 35 FT± SPACING BEGINNING 21FT± NORTH OF RIGHT BRIDGE CORNER TYPE 3 OBJECT MARKER.INSTALL BEHIND GUARDRAIL		7	
SB	MM 0.028, LT	F	WI-6 L	48	24			8.00								2		X								INSTALL NEW SIGN ON 2-POSTS 63 FT NORTH OF LEFT BRIDGE CORNER - AT RIGHT ANGLE TO APPROACHING TRAFFIC	X		
SB	MM 0.035, LT	F	RI-2	36	36			3.89								I		X								INSTALL NEW SIGN AND POST 132 FT NORTH OF LEFT BRIDGE CORNER - TYPE 3 OBJECT MARKER	X		
		F	RI-2A	24	18			3.00										X								INSTALL BENEATH YIELD SIGN AT THE CORRECT SIGN HEIGHT	X		
NB	MM 0.041, RT	A	R2-1	24	30					X				X												RETAIN SIGN AND POST			
NB	MM 0.065, RT	C	WI-6 R	48	24								X		X											REMOVE SIGN AND POSTS			
NB	MM 0.072, RT	B	WI-6 R	48	24			8.00								2		X								INSTALL NEW SIGN ON 2-POSTS 296 FT NORTH OF RIGHT BRIDGE CORNER AND 32 FT NORTH OF PVT DRIVE JUST NORTH OF PULL-OFF	X		
NB	MM 0.073, RT	C	WI-6 L	48	24		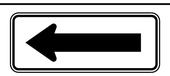	8.00								2		X								INSTALL NEW SIGN ON 2-POSTS 301FT NORTH OF RIGHT BRIDGE CORNER AND 37 FT NORTH OF PVT DRIVE JUST NORTH OF PULL-OFF	X		
SB	MM 0.080, LT	F	W3-2A	36	36			9.00								2		X								INSTALL NEW SIGN AND POST 338 FT NORTH OF LEFT BRIDGE CORNER - 74 NORTH OF AND ACROSS FROM PVT DRIVE	X		
										EA 3	EA	EA	EA 3	EA 2	EA 4		FT 112	FT 165	FT					LB	LB	LB	LB				
							SHEET SUBTOTALS	SF 54.23	SF	EA 6				EA ~~6~~		EA ~~25~~	FT 277			EA	LB								

FINAL POST LENGTHS ARE TO BE DETERMINED IN THE FIELD. POST SIZES ARE COMPUTED BASED ON INFORMATION FURNISHED ON THE STANDARD SHEETS AND THE VTRANS "SIGN POST DESIGN GUIDELINE".

PROJECT NAME: STATEWIDE NORTHWEST REGION
PROJECT NUMBER: STP HRRR(5)

FILE NAME: 10k018_wrk.dgn
PROJECT LEADER: JLS
DESIGNED BY: NLA
PLOT DATE: 17-SEP-2012 11:32
DRAWN BY: ITS
CHECKED BY: JLS
NEW HAVEN TRAFFIC SIGN SUMMARY SHEET 1 SHEET 23 OF 51