STATE OF VERMONT
AGENCY OF TRANSPORTATION

TRAFFIC SIGN SUMMARY SHEET 4 - NORWICH 1 (TURNPIKE ROAD)

DIRECTION	MILEMARKER, STATION, OR SIGN NUMBER	LOCATION	MANUAL ON UNIFORM TRAFFIC DEVICES OR STATE CODE	SIGN DIMENSIONS WIDTH	SIGN DIMENSIONS HEIGHT	SHEETING REMARKS	SIGN LEGEND	NEW SIGNS "A"	NEW SIGNS "B"	EXISTING SIGNS RETAIN	EXISTING SIGNS SALVAGE FROM	EXISTING SIGNS SALVAGE TO	EXISTING SIGNS REMOVE	EXISTING POST RETAIN	EXISTING POST REMOVE	NO. OF NEW POSTS	SQUARE STEEL (In) 1.75 lb/ft 1.88	SQUARE STEEL (In) 2.00 lb/ft 2.42	SQUARE STEEL (In) 2.50 lb/ft 3.35	TUBULAR STEEL O/(In) FOUNDATION	TUBULAR STEEL O/(In) 3.00 lb/ft 7.60	TUBULAR STEEL O/(In) 3.50 lb/ft 9.00	TUBULAR STEEL O/(In) 4.00 lb/ft 10.80	TUBULAR STEEL O/(In) 5.00 lb/ft 14.60	SIGN FRAME REQUIRED	REMARKS (SHS = STANDARD HIGHWAY SIGN BOOK)	SIGN DETAIL: DETAIL IN SHS	SIGN DETAIL: DETAIL ON SHEET NUMBER	SIGN DETAIL: STANDARD SHEET NUMBER
NB	MM 0.951, RT	C	WI-6 R	48	24			8.00								2		X									INSTALL NEW SIGN ON 2-POSTS 391 FT SOUTH OF AND ACROSS FROM POLE# GMP/2/NET/2 AT RIGHT ANGLES FOR SOUTHBOUND APPROACHING TRAFFIC ON TURNPIKE ROAD BEHIND GUARDRAIL	X		
~~NB~~ SB	MM 0.955, ~~LT~~ R	G	WI-6 L	48	24			8.00								2		X									INSTALL NEW SIGN ON 2-POSTS 370 FT SOUTH OF POLE# GMP/2/NET/2 AT RIGHT ANGLES FOR NORTHBOUND APPROACHING TRAFFIC TRAVELING ONTO TURNPIKE ROAD FROM NEW BOSTON RD	X		
NB	MM 0.958, RT	C/D	D3-1	48	12		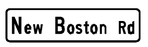 TURNPIKE RD	4.00			1	1	2							OLD NEW BOSTON RD SIGN REMOVED						INSTALL NEW ABOVE STOP SIGN ON SAME SIGN POST		9	
		B	RI-1	30	30			6.25					X		X	1		X									REMOVE SIGN AND POST. INSTALL NEW SIGN AND POST AT SAME LOCATION	X		
SB	MM 0.962, LT	F	RI-1	30	30			6.25					X		X	1		X									REMOVE SIGN AND POST. INSTALL NEW SIGN AND POST AT SAME LOCATION	X		
SB	MM 1.028, LT	F	W3-1	36	36			9.00								2		X									56 INSTALL NEW SIGN ON 2-POSTS ~~16~~ FT ~~NORTH~~ OF POLE# GMP/2/NET/2 SOUTH	X		
SB	MM 1.053, LT	F	W3-1	36	36								X		X												REMOVE SIGN AND POST			
							TILDEN HILL ROAD																							
SB	MM 0.069, LT	F	WI-2Mf R	30	30			6.25								1		X									INSTALL NEW SIGN AND POST ~~16 FT SOUTH AND~~ ACROSS FROM POLE# GMP/41/70125		9	
		F	W16-8P	36	8		New Boston Rd	2.00																			INSTALL NEW SIGN BENEATH MODIFIED CURVE WARNING SIGN AT CORRECT SIGN HEIGHT		9	
SB	MM 0.086, LT	F	D3-1	36	6		Tilden Hill Rd						X		X X												REMOVE SIGN AND POSTS			
		F	W2-2 L	30	30								X														REMOVE SIGN			
SB	MM 0.~~088~~ 6, LT	E/F	D3-1	42	12		Tilden Hill Rd	3.50												THIS SIGN WAS INSTALLED AT A DIFFERENT LOCATION THAN THE STOP SIGN.						INSTALL NEW SIGN ABOVE STOP SIGN ON ~~SAME SIGN~~ POST A SEPARATE		9	
SB	MM 0.088 LT	H	RI-1	30	30		STOP	6.25					X		X	1		X		FOR VISIBILITY REASONS, THIS SIGN WAS INSTALLED AT A DIFFERENT LOCATION						REMOVE SIGN AND POST. INSTALL NEW SIGN AND POST AT SAME LOCATION	X		
SB	MM 0.147, LT	F	WII-1	30	30			6.25								1		X									INSTALL NEW SIGN AND POST 300 FT NORTH OF THE CENTER OF THE TILDEN ROAD INTERSECTION WITH TURNPIKE ROAD	X		
		F	W16-1P	18	24		SHARE THE ROAD	3.00																			INSTALL NEW SIGN BENEATH BICYCLE SYMBOL WARNING SIGN AT THE CORRECT SIGN HEIGHT	X		
										EA	EA 1	EA 1	EA ~~8~~ 6	EA	EA 6			FT	FT 165	FT		LB	LB	LB	LB					
							SHEET SUBTOTALS	SF 68.75	SF	EA 6				EA 6		EA 11		FT 165		EA	LB									

FINAL POST LENGTHS ARE TO BE DETERMINED IN THE FIELD. POST SIZES ARE COMPUTED BASED ON INFORMATION FURNISHED ON THE STANDARD SHEETS AND THE VTRANS "SIGN POST DESIGN GUIDE".

PROJECT NAME: STATEWIDE SOUTHEAST REGION
PROJECT NUMBER: STP HRRR(6)

FILE NAME: 10k020_wrk.dgn
PROJECT LEADER: JLS
DESIGNED BY: NLA
NORWICH I TRAFFIC SIGN SUMMARY 4

PLOT DATE: 04-JUN-2010
DRAWN BY: ITS
CHECKED BY: JLS
SHEET 24 OF 44