STATE OF VERMONT
AGENCY OF TRANSPORTATION

TRAFFIC SIGN SUMMARY SHEET 4 - TOWNSHEND

DIRECTION	MILEMARKER, STATION, OR SIGN NUMBER	LOCATION	MANUAL ON UNIFORM TRAFFIC DEVICES OR STATE CODE	SIGN DIMENSIONS WIDTH	SIGN DIMENSIONS HEIGHT	SHEETING REMARKS	SIGN LEGEND	NEW SIGNS "A"	NEW SIGNS "B"	EXISTING SIGNS RETAIN	EXISTING SIGNS SALVAGE FROM	EXISTING SIGNS SALVAGE TO	EXISTING SIGNS REMOVE	EXISTING POST RETAIN	EXISTING POST REMOVE	NO. OF NEW POSTS	SQUARE STEEL (in) 1.75 lb/ft 1.88	SQUARE STEEL (in) 2.00 lb/ft 2.42	SQUARE STEEL (in) 2.50 lb/ft 3.35	TUBULAR STEEL O/(in) FOUNDATION	TUBULAR STEEL O/(in) 3.00 lb/ft 7.60	TUBULAR STEEL O/(in) 3.50 lb/ft 9.00	TUBULAR STEEL O/(in) 4.00 lb/ft 10.80	TUBULAR STEEL O/(in) 5.00 lb/ft 14.60	SIGN FRAME REQUIRED	REMARKS SHS = STANDARD HIGHWAY SIGN BOOK	SIGN DETAIL DETAIL IN SHS	SIGN DETAIL DETAIL ON SHEET NUMBER	SIGN DETAIL STANDARD SHEET NUMBER
SB	MM 2.336, LT	F	WI-2 R	30	30								X		X											REMOVE SIGN AND POST			
		F	TOWN SIGN	30	30								X													REMOVE SIGN			
		F	WI-10R	36	36			9.00								2		X								INSTALL NEW SIGN ON 2-POSTS ~~512~~ FT NORTH OF THE CENTER OF EAST HILL RD	X		
NB	MM 3.061, RT	A	WI-2 L	30	30								X		X											REMOVE SIGN AND POST			
		A	WI-10L	36	36			9.00								2		X								INSTALL NEW SIGN ON 2-POSTS ~~538~~ 475 FT SOUTH OF THE CENTER OF DEER VALLEY RD	X		
NB	MM 3.152, RT	C	VR-017	24	30		24,000	5.00					X		X	1		X		SIGN CHANGED TO 24,000 POUNDS WITH PERMISSION OF ROAD FOREMAN.						INSTALL NEW SIGN AND POST 75 FT EAST OF STOP SIGN LOCATION		7	
		D	RI-1	30	30			6.25					X													REMOVE SIGN AND POST AND INSTALL NEW SIGN ON ~~BACK SIDE OF LEGAL LOAD LIMIT SIGN ON THE SAME POST~~ SEPARATE POST	X		
NB	MM 3.175, RT	D	RI-1	30	30			6.25					~~X~~ MISSING		~~X~~	1		X								~~REMOVE SIGN AND POST AND~~ INSTALL NEW SIGN AND POST AT SAME LOCATION	X		
		C/D	D3-1	48	12			4.00					X		X											INSTALL NEW STREET NAME SIGN ABOVE STOP SIGN ON SAME POST		10	
SB	MM 3.239, LT	F	WI-2 ~~L~~ R	30	30								X		X											REMOVE SIGN AND POST			
		F	WI-10R	36	36			9.00					~~X~~ MISSING		~~X~~	2		X								INSTALL NEW SIGN ON 2- POSTS 401FT NORTH OF THE CENTER OF DEER VALLEY RD	X		
SB	MM 3.309, LT	F	S3-1	30	30	F-Y-G	VS3-4 36" X 36"	9.00 ~~6.25~~					X 2		X	1		X		AFTER THE S.B. STOP AHEAD SIGN WAS INSTALLED, IT WAS FOUND TO BE A TURN AROUND FOR THE SCHOOL BUS INSTEAD. THE CONTRACTOR INSTALLED THE LARGER SIGN						INSTALL NEW SIGN AND 770 FT NORTH OF THE CENTER OF DEER VALLEY RD			
NB	MM 3.425, RT	A	WI-10R	30	30								X		X											REMOVE SIGN AND POST			
		A	DI-1a	72	12		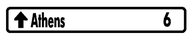	6.00								2		X								INSTALL NEW SIGNS ON 2-POSTS 333 FT SOUTH OF GRAFTON RD		10	
		A	DI-1a	72	12		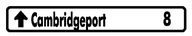	6.00																		INSTALL NEW SIGN BENEATH ATHENS DESTINATION SIGN ON THE SAME POSTS		10	
		A	DI-1a	72	12		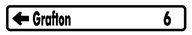	6.00																		INSTALL NEW SIGN BENEATH CAMBRIDGEPORT DESTINATION SIGN ON THE SAME POSTS		10	
										EA	EA	EA	EA ~~11~~ 10	EA	EA ~~9~~ 7		FT	FT 180	FT		LB	LB	LB	LB					
							SHEET SUBTOTALS	SF 72.75 81.75	SF	EA 11				EA 9		EA 11	FT 165			EA	LB								

FINAL POST LENGTHS ARE TO BE DETERMINED IN THE FIELD. POST SIZES ARE COMPUTED BASED ON INFORMATION FURNISHED ON THE STANDARD SHEETS AND THE VTRANS "SIGN POST DESIGN GUIDE".

PROJECT NAME: STATEWIDE SOUTHEAST REGION
PROJECT NUMBER: STP HRRR(6)

FILE NAME: 10k020_wrk.dgn
PROJECT LEADER: JLS
DESIGNED BY: NLA
TOWNSHEND TRAFFIC SIGN SUMMARY 4

PLOT DATE: 04-JUN-2010
DRAWN BY: ITS
CHECKED BY: JLS
SHEET 32 OF 44