STATE OF VERMONT
AGENCY OF TRANSPORTATION

TRAFFIC SIGN SUMMARY SHEET 3 – KILLINGTON

DIRECTION	MILEMARKER, STATION, OR SIGN NUMBER	LOCATION	MANUAL ON UNIFORM TRAFFIC DEVICES OR STATE CODE	SIGN DIMENSIONS WIDTH	SIGN DIMENSIONS HEIGHT	SHEETING REMARKS	SIGN LEGEND	NEW SIGNS "A"	NEW SIGNS "B"	EXISTING SIGNS RETAIN	EXISTING SIGNS SALVAGE FROM	EXISTING SIGNS SALVAGE TO	EXISTING SIGNS REMOVE	EXISTING POST RETAIN	EXISTING POST REMOVE	NO. OF NEW POSTS	SQUARE STEEL (In) 1.75 lb/ft 1.88	SQUARE STEEL (In) 2.00 lb/ft 2.42	SQUARE STEEL (In) 2.50 lb/ft 3.35	TUBULAR STEEL O/(In) FOUNDATION	TUBULAR STEEL O/(In) 3.00 lb/ft 7.60	TUBULAR STEEL O/(In) 3.50 lb/ft 9.00	TUBULAR STEEL O/(In) 4.00 lb/ft 10.80	TUBULAR STEEL O/(In) 5.00 lb/ft 14.60	SIGN FRAME REQUIRED	REMARKS SHS = STANDARD HIGHWAY SIGN BOOK	SIGN DETAIL DETAIL IN SHS	SIGN DETAIL DETAIL ON SHEET NUMBER	SIGN DETAIL STANDARD SHEET NUMBER
SB	MM 0.828, LT	F	W3-3	36	36		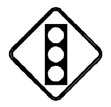	9.00					X		X	2		X								INSTALL NEW SIGN ON 2-POSTS 37 FT NORTH AND ACROSS FROM MOUNTAIN SPORTS INN ENTRANCE 10 FT SOUTH OF UTILITY POLE	X		
		F	W3-3P	24	18		SIGNAL AHEAD						X													REMOVE SIGN			
NB	MM 0.862, RT	D	R1-1	30	30		STOP	6.25					X		X	1		X								REMOVE SIGN AND POST INSTALL NEW SIGN AND POST AT SAME LOCATION	X		
		A/B	D3-1	42	12		Innsbruck Ln	3.50																		INSTALL NEW SIGN ABOVE STOP WITH UPDATED DESIGN		9	
NB	MM 0.865, 5T	A/B	D33-1	36	6		Innsbruck Ln						X		X											REMOVE SIGN AND POST			
SB	MM 0.882, LT	F	R2-1	00	00		SPEED LIMIT 35	5.00					X		X	1		X								INSTALL NEW SIGN AND POST 1341 FT SOUTH OFTHE EXISTING SPEED RADAR FEEDBACK SIGN	X		
		F	TOWN SIGN	24	12		RADAR ENFORCED						X													REMOVE SIGN			
NB	MM 0.895, RT	A	R4-2	24	30		PASS WITH CARE MISSING FROM FIELD REMOVED SL 35 IN PLACE						X		X											REMOVE SIGN AND POST			
SB	MM 0.916, LT	F	W1-2 R	30	30								X		X											REMOVE SIGN AND POST			
NB	MM 0.918, RT	D	R1-1	30	30		STOP	6.25					X		X	1		X								REMOVE SIGN AND POST INSTALL NEW SIGN AND POST AT SAME LOCATION	X		
SB	MM 0.993, LT	F	W1-2 R	30	30			6.25					X		X	1		X								INSTALL NEW SIGN AND POST AT 222 FT NORTH OF AND ACROSS FROM WEST HILL RD SIGNALIZED INTERSECTION	X		
NB	MM 0.993, RT	A	R2-1	24	30		SPEED LIMIT 35	5.00					X		X	1		X								INSTALL NEW SIGN AND POST 132 FT NORTH OF THE WEST HILL RD SIGNALIZED INTERSECTION	X		
		A	TOWN SIGN	24	12		RADAR ENFORCED						X													REMOVE SIGN			
NB	MM 1.001, RT	B A	W1-8 R W1-8 L	18 18	24 24		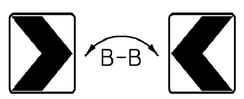	3.00 3.00								2 ~~1~~		X								INSTALLED BACK-TO-BACK ON A ~~SIGN BRACKET AND A SINGLE POST~~ 90 FT NORTH OF THE WEST HIIL RD SIGNALIZED INTERSECTION	X X		
							SHEET SUBTOTALS	SF 47.25	SF	EA 12				EA 9		EA 8		FT 120		EA				LB					

FINAL POST LENGTHS ARE TO BE DETERMINED IN THE FIELD. POST SIZES ARE COMPUTED BASED ON INFORMATION FURNISHED ON THE STANDARD SHEETS AND THE VTRANS "SIGN POST DESIGN GUIDELINE".

PROJECT NAME: STATEWIDE SOUTHWEST REGION
PROJECT NUMBER: STP HRRR(7)

FILE NAME: 10K022.DGN
PROJECT LEADER: N. AVERY
DESIGNED BY: N. AVERY
KILLINGTON TRAFFIC SIGN SUMMARY 3

PLOT DATE: 04-MAY-2010
DRAWN BY: N.AVERY
CHECKED BY: J. SCHULTZ
SHEET 30 OF 78