STATE OF VERMONT
AGENCY OF TRANSPORTATION

TRAFFIC SIGN SUMMARY SHEET 10 – KILLINGTON

DIRECTION	MILEMARKER, STATION, OR SIGN NUMBER	LOCATION	MANUAL ON UNIFORM TRAFFIC DEVICES OR STATE CODE	SIGN DIMENSIONS WIDTH	SIGN DIMENSIONS HEIGHT	SHEETING REMARKS	SIGN LEGEND	NEW SIGNS "A"	NEW SIGNS "B"	EXISTING SIGNS RETAIN	EXISTING SIGNS SALVAGE FROM	EXISTING SIGNS SALVAGE TO	EXISTING SIGNS REMOVE	EXISTING POST RETAIN	EXISTING POST REMOVE	NO. OF NEW POSTS	SQUARE STEEL (in) 1.75 lb/ft 1.88	SQUARE STEEL (in) 2.00 lb/ft 2.42	SQUARE STEEL (in) 2.50 lb/ft 3.35	TUBULAR STEEL O/(in) FOUNDATION	TUBULAR STEEL O/(in) 3.00 lb/ft 7.60	TUBULAR STEEL O/(in) 3.50 lb/ft 9.00	TUBULAR STEEL O/(in) 4.00 lb/ft 10.80	TUBULAR STEEL O/(in) 5.00 lb/ft 14.60	SIGN FRAME REQUIRED	REMARKS SHS = STANDARD HIGHWAY SIGN BOOK	SIGN DETAIL DETAIL IN SHS	SIGN DETAIL DETAIL ON SHEET NUMBER	SIGN DETAIL STANDARD SHEET NUMBER
NB	MM 3.031, RT	A	W3-3	36	36		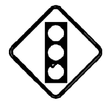						X		X											REMOVE SIGN			
		A	W11-2	30	30	F-Y-G	SIGN INSTALLED ON NEW POST. 10' SOUTH OF EXISTING SIGN BRACKET.	6.25																		INSTALL NEW SIGN ON EXISTING SIGN BRACKET NEXT TO FLASHING BEACON	X		
		A	W16-9P	24	12	F-Y-G	AHEAD	2.00																		INSTALL BENEATH PEDESTRIAN SYMBOL WARNING SIGN AT THE CORRECT SIGN HEIGHT	X		
SB	MM 3.077, LT	F	R4-3	24	30		SLOWER TRAFFIC KEEP RIGHT	5.00					X		X	1		X								INSTALL NEW SIGN AND POST 243 FT SOUTH OF AND ACROSS FROM UTILITY POLE WITH FLASHING BEACON	X		