STATE OF VERMONT
AGENCY OF TRANSPORTATION

TRAFFIC SIGN SUMMARY SHEET 1 - MANCHESTER

DIRECTION	MILEMARKER, STATION, OR SIGN NUMBER	LOCATION	MANUAL ON UNIFORM TRAFFIC DEVICES OR STATE CODE	SIGN DIMENSIONS WIDTH	SIGN DIMENSIONS HEIGHT	SHEETING REMARKS	SIGN LEGEND	NEW SIGNS "A"	NEW SIGNS "B"	EXISTING SIGNS RETAIN	EXISTING SIGNS SALVAGE FROM	EXISTING SIGNS SALVAGE TO	EXISTING SIGNS REMOVE	EXISTING POST RETAIN	EXISTING POST REMOVE	NO. OF NEW POSTS	SQUARE STEEL (in) 1.75 lb/ft 1.88	SQUARE STEEL (in) 2.00 lb/ft 2.42	SQUARE STEEL (in) 2.50 lb/ft 3.35	TUBULAR STEEL O/(in) FOUNDATION	TUBULAR STEEL O/(in) 3.00 lb/ft 7.60	TUBULAR STEEL O/(in) 3.50 lb/ft 9.00	TUBULAR STEEL O/(in) 4.00 lb/ft 10.80	TUBULAR STEEL O/(in) 5.00 lb/ft 14.60	SIGN FRAME REQUIRED	REMARKS SHS = STANDARD HIGHWAY SIGN BOOK	SIGN DETAIL DETAIL IN SHS	SIGN DETAIL DETAIL ON SHEET NUMBER	SIGN DETAIL STANDARD SHEET NUMBER
							BARNUMVILLE ROAD SLIP RAMP																						
WB	MM 0.006, LT	F	RI-1	30	30		REMOVED AT PREVIOUS	6.25					X		X	1		X								REMOVE SIGN AND POST INSTALL NEW SIGN AND POST AT SAME LOCATION	X		
EB	MM 0.010, RT	A	RI-1	30	30		REMOVED AT PREVIOUS	6.25					X		X	1		X								REMOVE SIGN AND POST INSTALL NEW SIGN AND POST AT SAME LOCATION	X		
							BARNUMVILLE ROAD																						
WB	MM 0.018, LT	F	RI-1	30	30		NEW WITH NEW REFLECTIVE SHEETING	6.25					X		X	1		X								REMOVE SIGN AND POST INSTALL NEW SIGN AND POST AT SAME LOCATION	X		
EB	MM 0.051, RT	A	R2-1	24	30			5.00								1		X								INSTALL NEW SIGN AND POST 50 FT EAST OF THE CENTER OF BAKER FARM ROAD (PVT)	X		
WB	MM 0.055, LT	F	W3-1	36	36		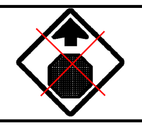	9.00								2		X								INSTALL NEW SIGN ON 2-POSTS ACROSS THE ROADWAY FROM POLE #6/20-2	X		
EB	MM 0.079, RT	A	R2-1	24	30								X		X											REMOVE SIGN AND POST			
WB	MM 0.146, LT	F	OM-3L	12	36								X		X											REMOVE EXISTING SIGN AND POST			
EB	MM 0.158, RT	A	W2-2	30	30			6.25								1		X								INSTALL NEW SIGN AND POST 67 FT WEST OF POLE #21-1/401, 200 FT WEST OF CENTER OF HIGHLAND AVENUE	X		
		A	W16-8P	30	8			1.67																	INSTALL BENEATH SIDE ROAD WARNING SIGN AT THE CORRECT SIGN HEIGHT		8	
WB	MM 0.174, LT	F	R2-1	24	30			5.00								1		X								INSTALL NEW SIGN AND POST 285 FT WEST OF POLE #211/22/399	X		
WB	MM 0.196, RT	G	W1-7	48	24			8.00								2		X								INSTALL NEW SIGN AND POST 169 FT WEST OF POLE #211/22/399 DIRECTLY ACROSS THE INTERSECTION OF HIGHLAND AVE	X		
EB	MM 0.203,RT	D	R1-1	30	30		NEW WITH NEW SHEETING EXISTING	6.25					X		X	1		X								REMOVE SIGN AND POST INSTALL NEW SIGN AND POST AT SAME LOCATION	X		
										EA	EA	EA	EA 6	EA	EA 6		FT	FT 165	FT		LB	LB	LB	LB					
							SHEET SUBTOTALS	SF 59.92	SF	EA 6				EA 6		EA 11	FT 165			EA	LB								

FINAL POST LENGTHS ARE TO BE DETERMINED IN THE FIELD. POST SIZES ARE COMPUTED BASED ON INFORMATION FURNISHED ON THE STANDARD SHEETS AND THE VTRANS "SIGN POST DESIGN GUIDELINE".

PROJECT NAME: STATEWIDE SOUTHWEST REGION
PROJECT NUMBER: STP HRRR(7)

FILE NAME: 10K022.DGN
PROJECT LEADER: N. AVERY
DESIGNED BY: N. AVERY
MANCHESTER TRAFFIC SIGN SUMMARY 1

PLOT DATE: 04-MAY-2010
DRAWN BY: N.AVERY
CHECKED BY: J. SCHULTZ
SHEET 39 OF 78