STATE OF VERMONT
AGENCY OF TRANSPORTATION

TRAFFIC SIGN SUMMARY SHEET 6 - RUPERT

DIRECTION	MILEMARKER, STATION, OR SIGN NUMBER	LOCATION	MANUAL ON UNIFORM TRAFFIC DEVICES OR STATE CODE	SIGN DIMENSIONS WIDTH	SIGN DIMENSIONS HEIGHT	SHEETING REMARKS	SIGN LEGEND	NEW SIGNS "A"	NEW SIGNS "B"	EXISTING SIGNS RETAIN	EXISTING SIGNS SALVAGE FROM	EXISTING SIGNS SALVAGE TO	EXISTING SIGNS REMOVE	EXISTING POST RETAIN	EXISTING POST REMOVE	NO. OF NEW POSTS	SQUARE STEEL (In) 1.75 lb/ft 1.88	SQUARE STEEL (In) 2.00 lb/ft 2.42	SQUARE STEEL (In) 2.50 lb/ft 3.35	TUBULAR STEEL O/(In) FOUNDATION	TUBULAR STEEL O/(In) 3.00 lb/ft 7.60	TUBULAR STEEL O/(In) 3.50 lb/ft 9.00	TUBULAR STEEL O/(In) 4.00 lb/ft 10.80	TUBULAR STEEL O/(In) 5.00 lb/ft 14.60	SIGN FRAME REQUIRED	REMARKS SHS = STANDARD HIGHWAY SIGN BOOK	SIGN DETAIL DETAIL IN SHS	SIGN DETAIL DETAIL ON SHEET NUMBER	SIGN DETAIL STANDARD SHEET NUMBER
SB	MM 3.503, LT	F	WI-6 L	48	24		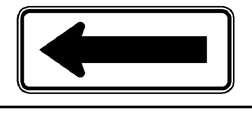	8.00								2		X								INSTALL NEW SIGN ON 2-POSTS 771FT SOUTH OF AND ACROSS FROM POLE# CV276/18 AT RIGHT ANGLES TO APPROACHING TRAFFIC	X		
SB	MM 3.564, LT	E	WI-6 R	48	24		ALSO AN 18X18 OBJECT MARKER AND MILE MARKER REMOVED 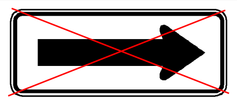	8.00					X		X	2		X								INSTALL NEW SIGN ON 2-POSTS 776 FT SOUTH OF AND ACROSS FROM POLE# CV276/18 AT RIGHT ANGLES TO APPROACHING TRAFFIC	X		
SB	MM 3.568, LT	F	WI-6 L	48	24		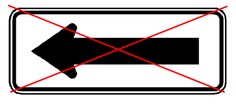	8.00					X		X	2		X								INSTALL NEW SIGN ON 2-POSTS 428 FT SOUTH OF AND ACROSS FROM POLE# CV276/18 AT RIGHT ANGLES TO APPROACHING TRAFFIC	X		
SB	MM 3.649, LT	F	WI-2 L	30	30			6.25								1		X								INSTALL NEW SIGN AND POST DIRECTLY ACROSS FROM POLE# CV276/18	X		
SB	MM 3.671,LT	F	WI-2 L	30	30								X		X											REMOVE SIGN AND POST			
NB	MM 3.957, RT	A	WI-2 R	30	30			6.25								1		X								INSTALL NEW SIGN AND POST 306 FT SOUTH OF AND ACROSS FROM POLE# 268/26	X		
SB	MM 4.019, LT	F	WI-2 L	30	30			6.25								1		X								INSTALL NEW SIGN AND POST 20 FT NORTH OF POLE# 268/26	X		
NB	MM 4.190, RT	A	WI-4Mb R	30	30			6.25								1		X								INSTALL NEW SIGN AND POST 808 FT SOUTH OF THE INTERSECTION OF LEWIS ROAD		II	
		A	W16-8P	24	8		INSTALLED ON SEPERATE POST AND REMOVED	1.33																		INSTALL BENEATH MODIFIED RIGHT REVERSE CURVE WARNING SIGN AT THE CORRECT SIGN HEIGHT		II	
NB	MM 4.245, RT	A/B	D3-1	24	6								X		X											REMOVE SIGN AND POST			
NB	MM 4.260, RT	A/B	D3-1	30	12		INSTALLED 70' FROM INTERSECTION AOBE DUE TO A LARGE TREE.	2.50																		INSTALL SIGN ABOVE STOP WITH UPDATED DESIGN		II	
		D	R1-1	30	30			6.25								1		X								INSTALL NEW SIGN AND POST ON RIGHT SIDE OF TOWN HIGHWAY AS PER STANDARD	X		
SB	MM 4.348, LT	F	W1-1MJ L(R)	30	30			6.25								1		X								INSTALL NEW SIGN AND POST 25 FT NORTH OF POLE# 261/33		II	
		F	W16-8P	24	8			1.33																		INSTALL BENEATH MODIFIED LEFT CURVE WARNING SIGN AT THE CORRECT SIGN HEIGHT		II	
SB	MM 5.410, LT	E/F	D3-1	30	6								X		X											REMOVE SIGN AND POST			
		G	VD-700	6	10								X													REMOVE SIGN			
										EA	EA	EA	EA	EA	EA		FT	FT	FT		LB	LB	LB	LB					
													6		5			180											
							SHEET SUBTOTALS	SF 66.66	SF	EA 6				EA 5		EA 12	FT 180			EA	LB							

FINAL POST LENGTHS ARE TO BE DETERMINED IN THE FIELD. POST SIZES ARE COMPUTED BASED ON INFORMATION FURNISHED ON THE STANDARD SHEETS AND THE VTRANS "SIGN POST DESIGN GUIDELINE".

PROJECT NAME: STATEWIDE SOUTHWEST REGION
PROJECT NUMBER: STP HRRR(7)

FILE NAME: 10K022.DGN
PROJECT LEADER:
DESIGNED BY: N. AVERY
RUPERT TRAFFIC SIGN SUMMARY 6

PLOT DATE: 04-MAY-2010
DRAWN BY: N.AVERY
CHECKED BY: J. SCHULTZ
SHEET 57 OF 78