STATE OF VERMONT
AGENCY OF TRANSPORTATION

TRAFFIC SIGN SUMMARY SHEET 5 - SUNDERLAND

DIRECTION	MILEMARKER, STATION, OR SIGN NUMBER	LOCATION	MANUAL ON UNIFORM TRAFFIC DEVICES OR STATE CODE	SIGN DIMENSIONS WIDTH	SIGN DIMENSIONS HEIGHT	SHEETING REMARKS	SIGN LEGEND	NEW SIGNS "A"	NEW SIGNS "B"	EXISTING SIGNS RETAIN	EXISTING SIGNS SALVAGE FROM	EXISTING SIGNS SALVAGE TO	EXISTING SIGNS REMOVE	EXISTING POST RETAIN	EXISTING POST REMOVE	NO. OF NEW POSTS	SQUARE STEEL (In) 1.75 lb/ft 1.88	SQUARE STEEL (In) 2.00 lb/ft 2.42	SQUARE STEEL (In) 2.50 lb/ft 3.35	TUBULAR STEEL O/(In) FOUNDATION	TUBULAR STEEL O/(In) 3.00 lb/ft 7.60	TUBULAR STEEL O/(In) 3.50 lb/ft 9.00	TUBULAR STEEL O/(In) 4.00 lb/ft 10.80	TUBULAR STEEL O/(In) 5.00 lb/ft 14.60	SIGN FRAME REQUIRED	REMARKS SHS = STANDARD HIGHWAY SIGN BOOK	SIGN DETAIL DETAIL IN SHS	SIGN DETAIL DETAIL ON SHEET NUMBER	SIGN DETAIL STANDARD SHEET NUMBER
NB	MM 1.192, RT	A	D3-1	36	12								X		X											REMOVE SIGN AND POST			
NB	MM 1.235, RT	A	S1-1	36	36	F-Y-G		9.00								2		X								INSTALL NEW SIGN ON 2-POSTS 25 FT SOUTH OF POLE# 95/25T/58	X		
		A	W16-9P	24	12	F-Y-G		2.00																		INSTALL BENEATH ADVANCE SCHOOL SYMBOL SIGN AT THE CORRECT SIGN HEIGHT	X		
SB	MM 1.299, LT	H	R1-1	30	30		INSTALLED STREET SIGN AT SCHOOL NOT IN FIELD	6.25 3.00					~~X~~		X	1		X								INSTALL NEW SIGN AND POST ON RIGHT SIDE OF TOWN HIGHWAY IN FRONT OF MAPLE TREE AS PER STANDARD	X		
SB	MM 1.368, LT	F	S1-1	36	36	F-Y-G		9.00								2		X								INSTALL NEW SIGN ON 2-POSTS 53 FT SOUTH OF POLE# 2/98/4-5/65	X		
		F	W16-9P	24	12	F-Y-G		2.00																		INSTALL BENEATH ADVANCE SCHOOL SYMBOL SIGN AT THE CORRECT SIGN HEIGHT	X		
NB	MM 1.412, RT	A	W1-2 L	30	30			6.25								1		X								INSTALL NEW SIGN AND POST 53 FT SOUTH OF POLE# 50T/25T/2/103/66	X		
SB	MM 1.425, LT	F	S1-1	30	30								X		X											REMOVE SIGN AND POST			
SB	MM 1.443, LT	F	R1-1	30	30								X		X											REMOVE SIGN AND POST			
SB	MM 1.489, LT	F	W1-2 R	30	30			6.25								1		X								INSTALL NEW SIGN AND POST 100 FT SOUTH OF POLE# 106/69	X		
NB	MM 1.733, RT	A	W2-2 R	30	30		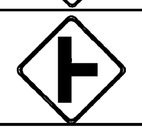 SIGN REMOVED IN FIELD	6.25					X			1		X								INSTALL NEW SIGN ON 2-POSTS 250 FT SOUTH OF POLE# 2/98/4-5/65	X		
		A	W16-8	42	8		SIGN REMOVED IN FIELD	2.33					X													INSTALL BENEATH SIDE ROAD WARNING SIGN AT THE CORRECT SIGN HEIGHT		13	
SB	MM 1.755, LT	F	R2-1	24	30			5.00								1		X								INSTALL NEW SIGN AND POST 21FT NORTH OF POLE# 114/78	X		
NB	MM 1.775, RT	D	R1-1	30	30		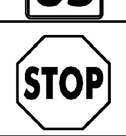	6.25					X		X	1		X								INSTALL NEW SIGN AND POST ON LEFT SIDE OF BACON HOLLOW ROAD DIRECTLY ACROSS FROM STOP SIGN ON RIGHT SIDE	X		
SB	MM 1.780, LT	G	D3-1	60	12			5.00								2		X								INSTALL NEW SIGN ON 2-POSTS DIRECTLY ACROSS FROM BACON HOLLOW ROAD INTERSECTION WITH SUNDERLAND ROAD		13	
										EA	EA	EA	EA 5	EA	EA 5		FT	FT 180	FT					LB	LB	LB	LB				
							SHEET SUBTOTALS	SF 65.58	SF	EA 5				EA 5		EA 12	FT 180			EA	LB									

FINAL POST LENGTHS ARE TO BE DETERMINED IN THE FIELD. POST SIZES ARE COMPUTED BASED ON INFORMATION FURNISHED ON THE STANDARD SHEETS AND THE VTRANS "SIGN POST DESIGN GUIDELINE".

PROJECT NAME: STATEWIDE SOUTHWEST REGION
PROJECT NUMBER: STP HRRR(7)

FILE NAME: 10K022.DGN
PROJECT LEADER:
DESIGNED BY: N. AVERY
SUNDERLAND TRAFFIC SIGN SUMMARY 5

PLOT DATE: 04-MAY-2010
DRAWN BY: N.AVERY
CHECKED BY: J. SCHULTZ
SHEET 66 OF 78