STATE OF VERMONT
AGENCY OF TRANSPORTATION

TRAFFIC SIGN SUMMARY SHEET 11 - SUNDERLAND

DIRECTION	MILEMARKER, STATION, OR SIGN NUMBER	LOCATION	MANUAL ON UNIFORM TRAFFIC DEVICES OR STATE CODE	SIGN DIMENSIONS WIDTH	SIGN DIMENSIONS HEIGHT	SHEETING REMARKS	SIGN LEGEND	NEW SIGNS "A"	NEW SIGNS "B"	EXISTING SIGNS RETAIN	EXISTING SIGNS SALVAGE FROM	EXISTING SIGNS SALVAGE TO	EXISTING SIGNS REMOVE	EXISTING POST RETAIN	EXISTING POST REMOVE	NO. OF NEW POSTS	SQUARE STEEL (In) 1.75 lb/ft 1.88	SQUARE STEEL (In) 2.00 lb/ft 2.42	SQUARE STEEL (In) 2.50 lb/ft 3.35	TUBULAR STEEL O/(In) FOUNDATION	TUBULAR STEEL O/(In) 3.00 lb/ft 7.60	TUBULAR STEEL O/(In) 3.50 lb/ft 9.00	TUBULAR STEEL O/(In) 4.00 lb/ft 10.80	TUBULAR STEEL O/(In) 5.00 lb/ft 14.60	SIGN FRAME REQUIRED	REMARKS SHS = STANDARD HIGHWAY SIGN BOOK	SIGN DETAIL DETAIL IN SHS	SIGN DETAIL DETAIL ON SHEET NUMBER	SIGN DETAIL STANDARD SHEET NUMBER
SB	MM 4.425, LT	F	WI-6 L	48	24		MOVED 70' SOUTH DUE TO TREES.	8.00								2		X								INSTALL NEW SIGN ON 2-POSTS 16 FT NORTH OF POLE# 25T/50 AT RIGHTANGLES TO APPROACHING TRAFFIC	X		
SB	MM 4.458, LT	A	WI-4 L	30	30			6.25								1		X								INSTALL NEW SIGN AND POST 10 FT NORTH OF POLE# 51	X		
SB	MM 4.765, LT	F	R2-1	24	30			5.00					X		X	1		X								INSTALL NEW SIGN AND POST 48 FT SOUTH OF AND ACROSS FROM POLE# 32/59/34	X		
NB	MM 4.765, RT	C	VD-025	72	10			6.00								2		X								INSTALL NEW SIGN ON 2-POSTS 48 FT SOUTH OF POLE# 32/59/34		13	
							BACON HILL ROAD																						
EB	STA 1+30, RT	A	VR-017	24	30			5.00								1		X								INSTALL NEW SIGN AND POST 130 FT EAST OF THE INTERSECTION OF SUNDERLAND RD ON THE SOUTH (RIGHT) SIDE OF BACON HILL ROAD		7	
		A	R2-1	24	30			5.00					X		X											INSTALL NEW SIGN BENEATH LEGAL LOAD LIMIT SIGN AT THE CORRECT SIGN HEIGHT	X		
EB	STA 4+50, RT	A	R2-1	24	30								X		X											REMOVE SIGN AND POST			
		A	VR-017	24	30								X													REMOVE SIGN			
WB	STA 5+45, LT	F	W3-1	36	36		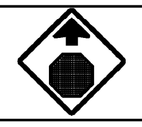	9.00								2		X								INSTALL NEW SIGN ON 2- POSTS 545 FT EAST OF THE INTERSECTION OF SUNDERLAND RD ON THE NORTH (LEFT) SIDE OF BACON HILL ROAD	X		
							HILL FARM ROAD																						
WB	STA 00+91, RT	F	VR-017	24	30								X		X											REMOVE SIGN AND POST			
WB	STA 1+43, LT	F	VR-017	24	30			5.00								1		X								INSTALL NEW SIGN AND POST 143 FT WEST OF THE INTERSECTION OF SUNDERLAND RD ON THE NORTH (RIGHT) SIDE OF FARM HILL ROAD		7	
		F	R2-1	24	30			5.00					X		X											INSTALL BENEATH LEGAL LOAD LIMIT SIGN AT THE CORRECT SIGN HEIGHT	X		
EB	STA. 3+96, RT	A	W3-1	36	36		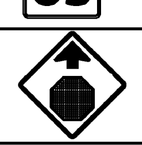	9.00								2		X								INSTALL NEW SIGN ON 2- POSTS 396 FT WEST OF THE INTERSECTION OF SUNDERLAND RD ON THE SOUTH (LEFT) SIDE OF FARM HILL ROAD	X		
										EA	EA	EA	EA	EA	EA		FT	FT	FT			LB	LB	LB	LB					
													6		5			180												
							SHEET SUBTOTALS	SF 63.25	SF	EA 6				EA 5		EA 12	FT 180			EA	LB									

FINAL POST LENGTHS ARE TO BE DETERMINED IN THE FIELD. POST SIZES ARE COMPUTED BASED ON INFORMATION FURNISHED ON THE STANDARD SHEETS AND THE VTRANS "SIGN POST DESIGN GUIDELINE".

PROJECT NAME: STATEWIDE SOUTHWEST REGION
PROJECT NUMBER: STP HRRR(7)

FILE NAME: 10K022.DGN
PROJECT LEADER:
DESIGNED BY: N. AVERY
SUNDERLAND TRAFFIC SIGN SUMMARY II

PLOT DATE: 04-MAY-2010
DRAWN BY: N.AVERY
CHECKED BY: J. SCHULTZ
SHEET 72 OF 78