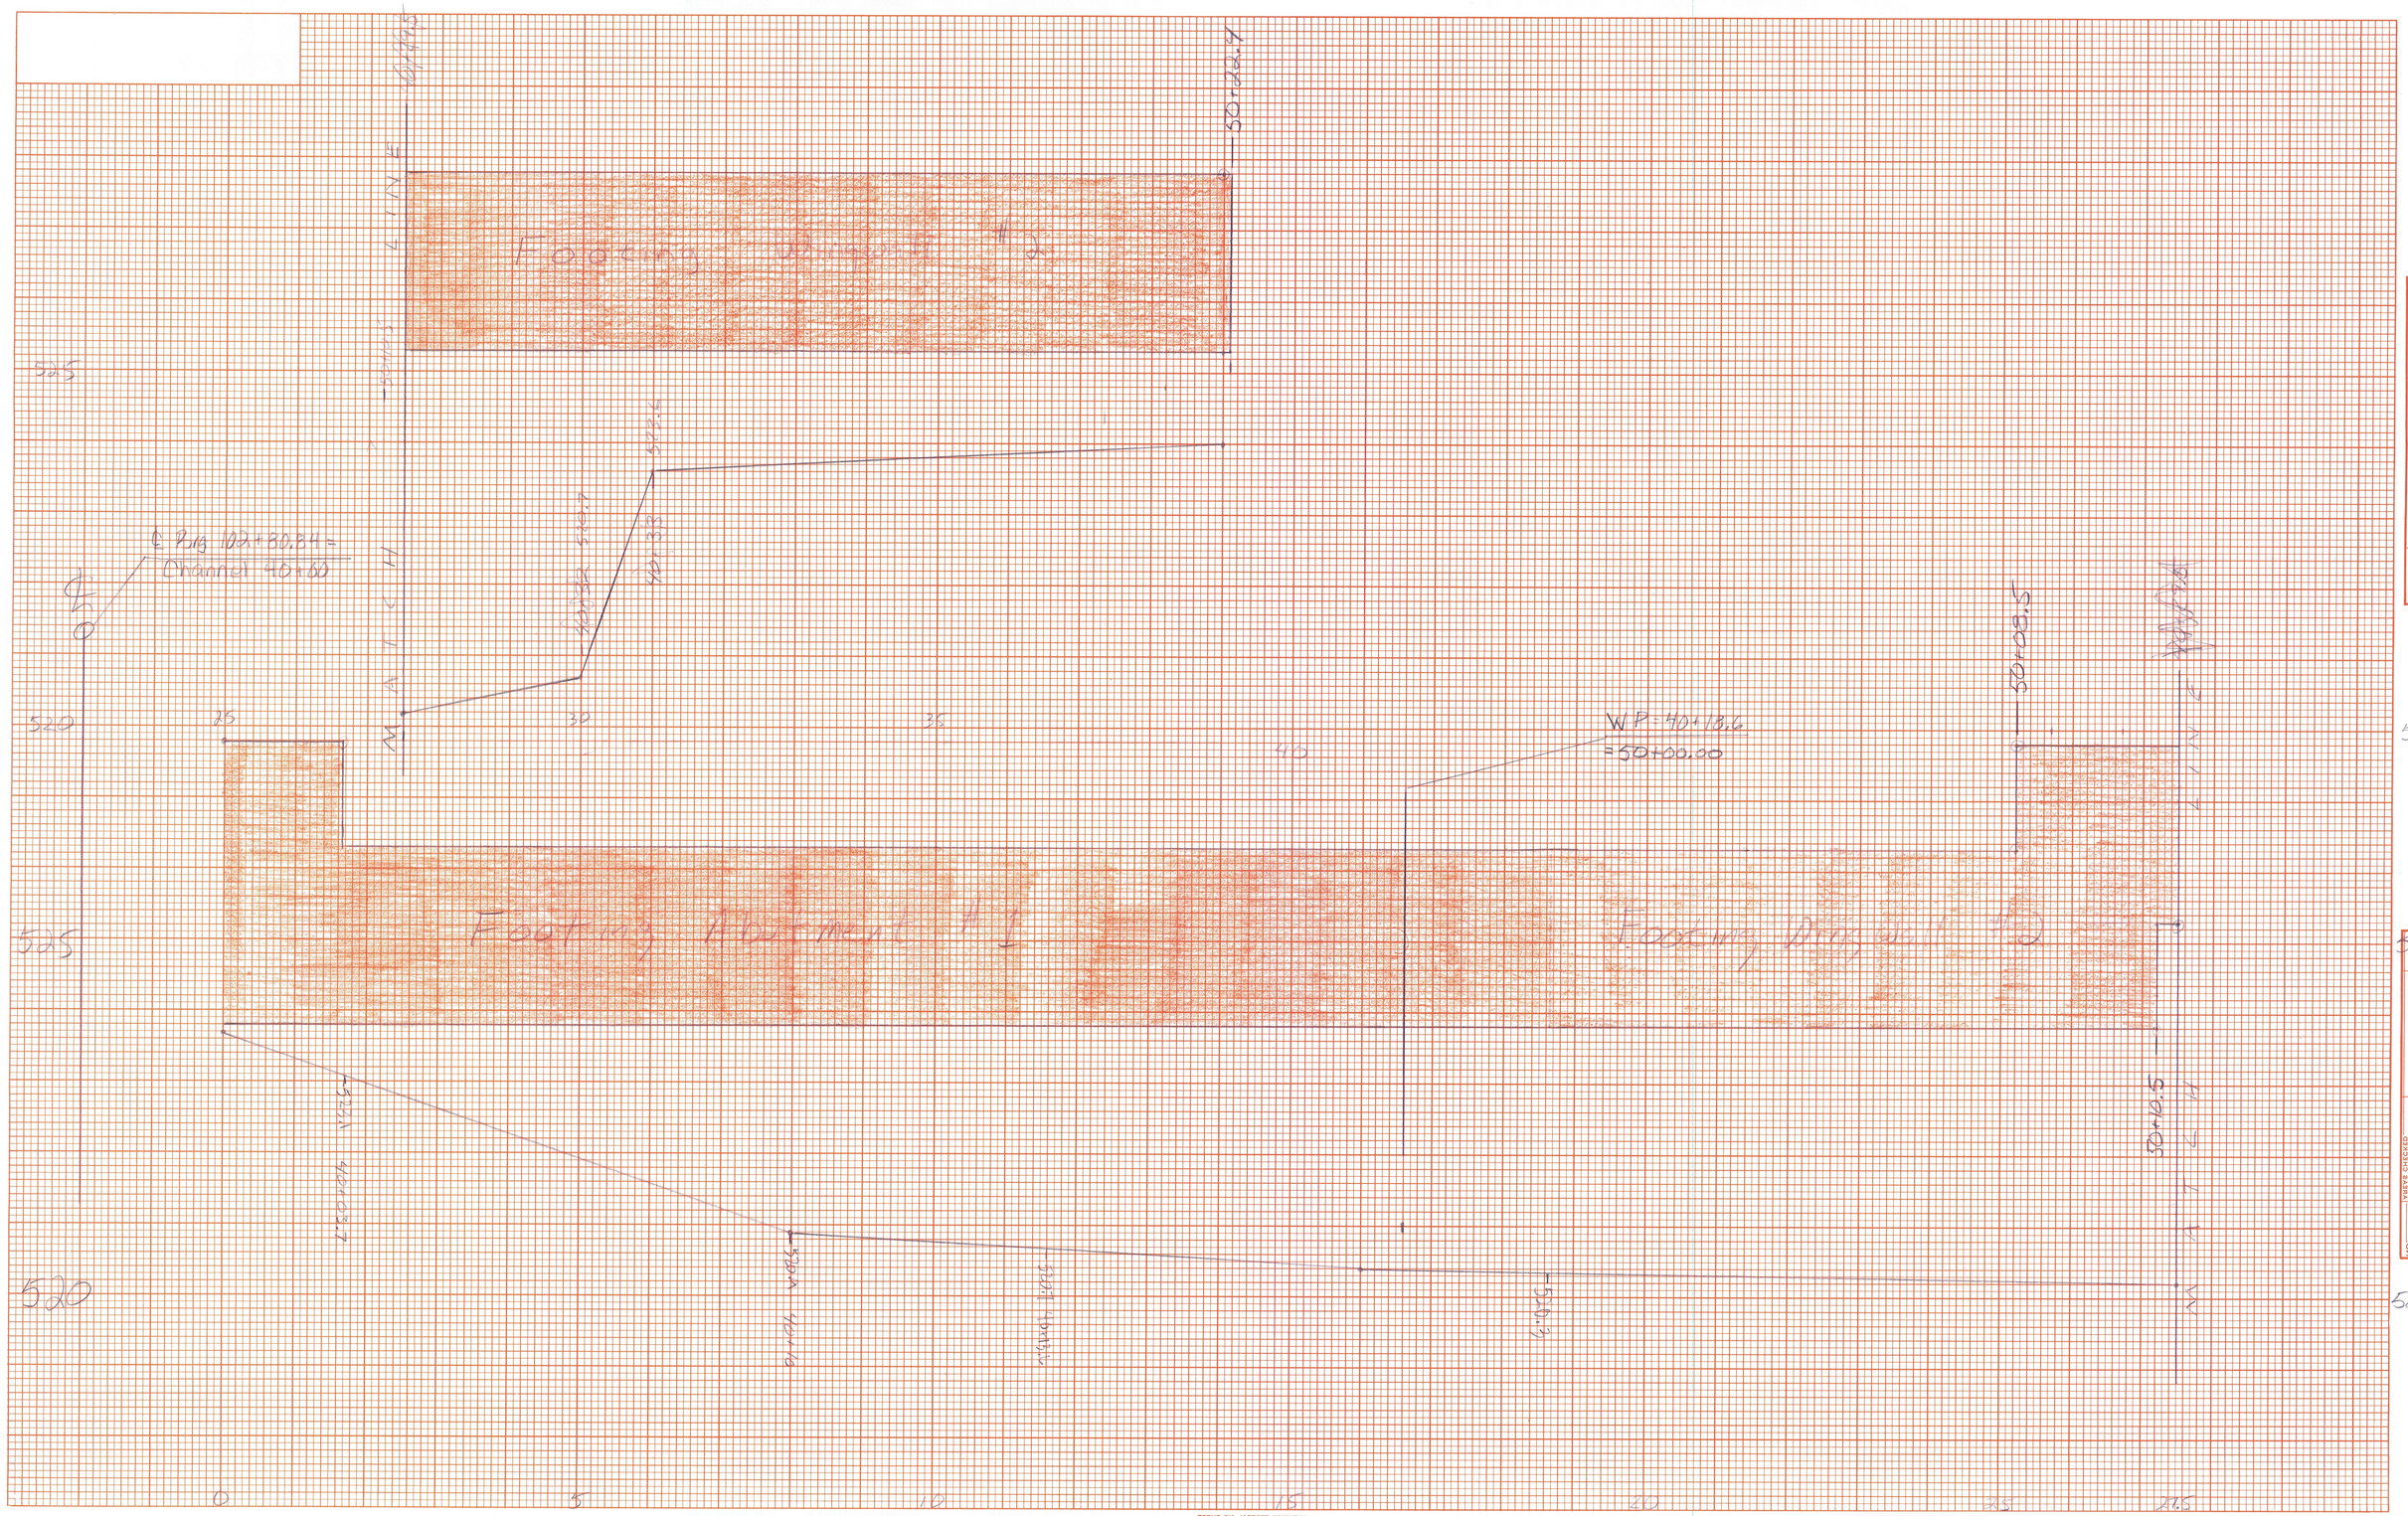


FINAL SURVEY
MOTE BOOK
NO. 2106A
AREA
DETAILED BY
CHECKED BY
DATE
REVISED
BY
DATE

PLATE 3-FULL CROSS SECTION-FULL LINE
HIGHWAY FEDERAL AID SHEET
NATIONAL PRINTING
PRINTED IN U.S.A.