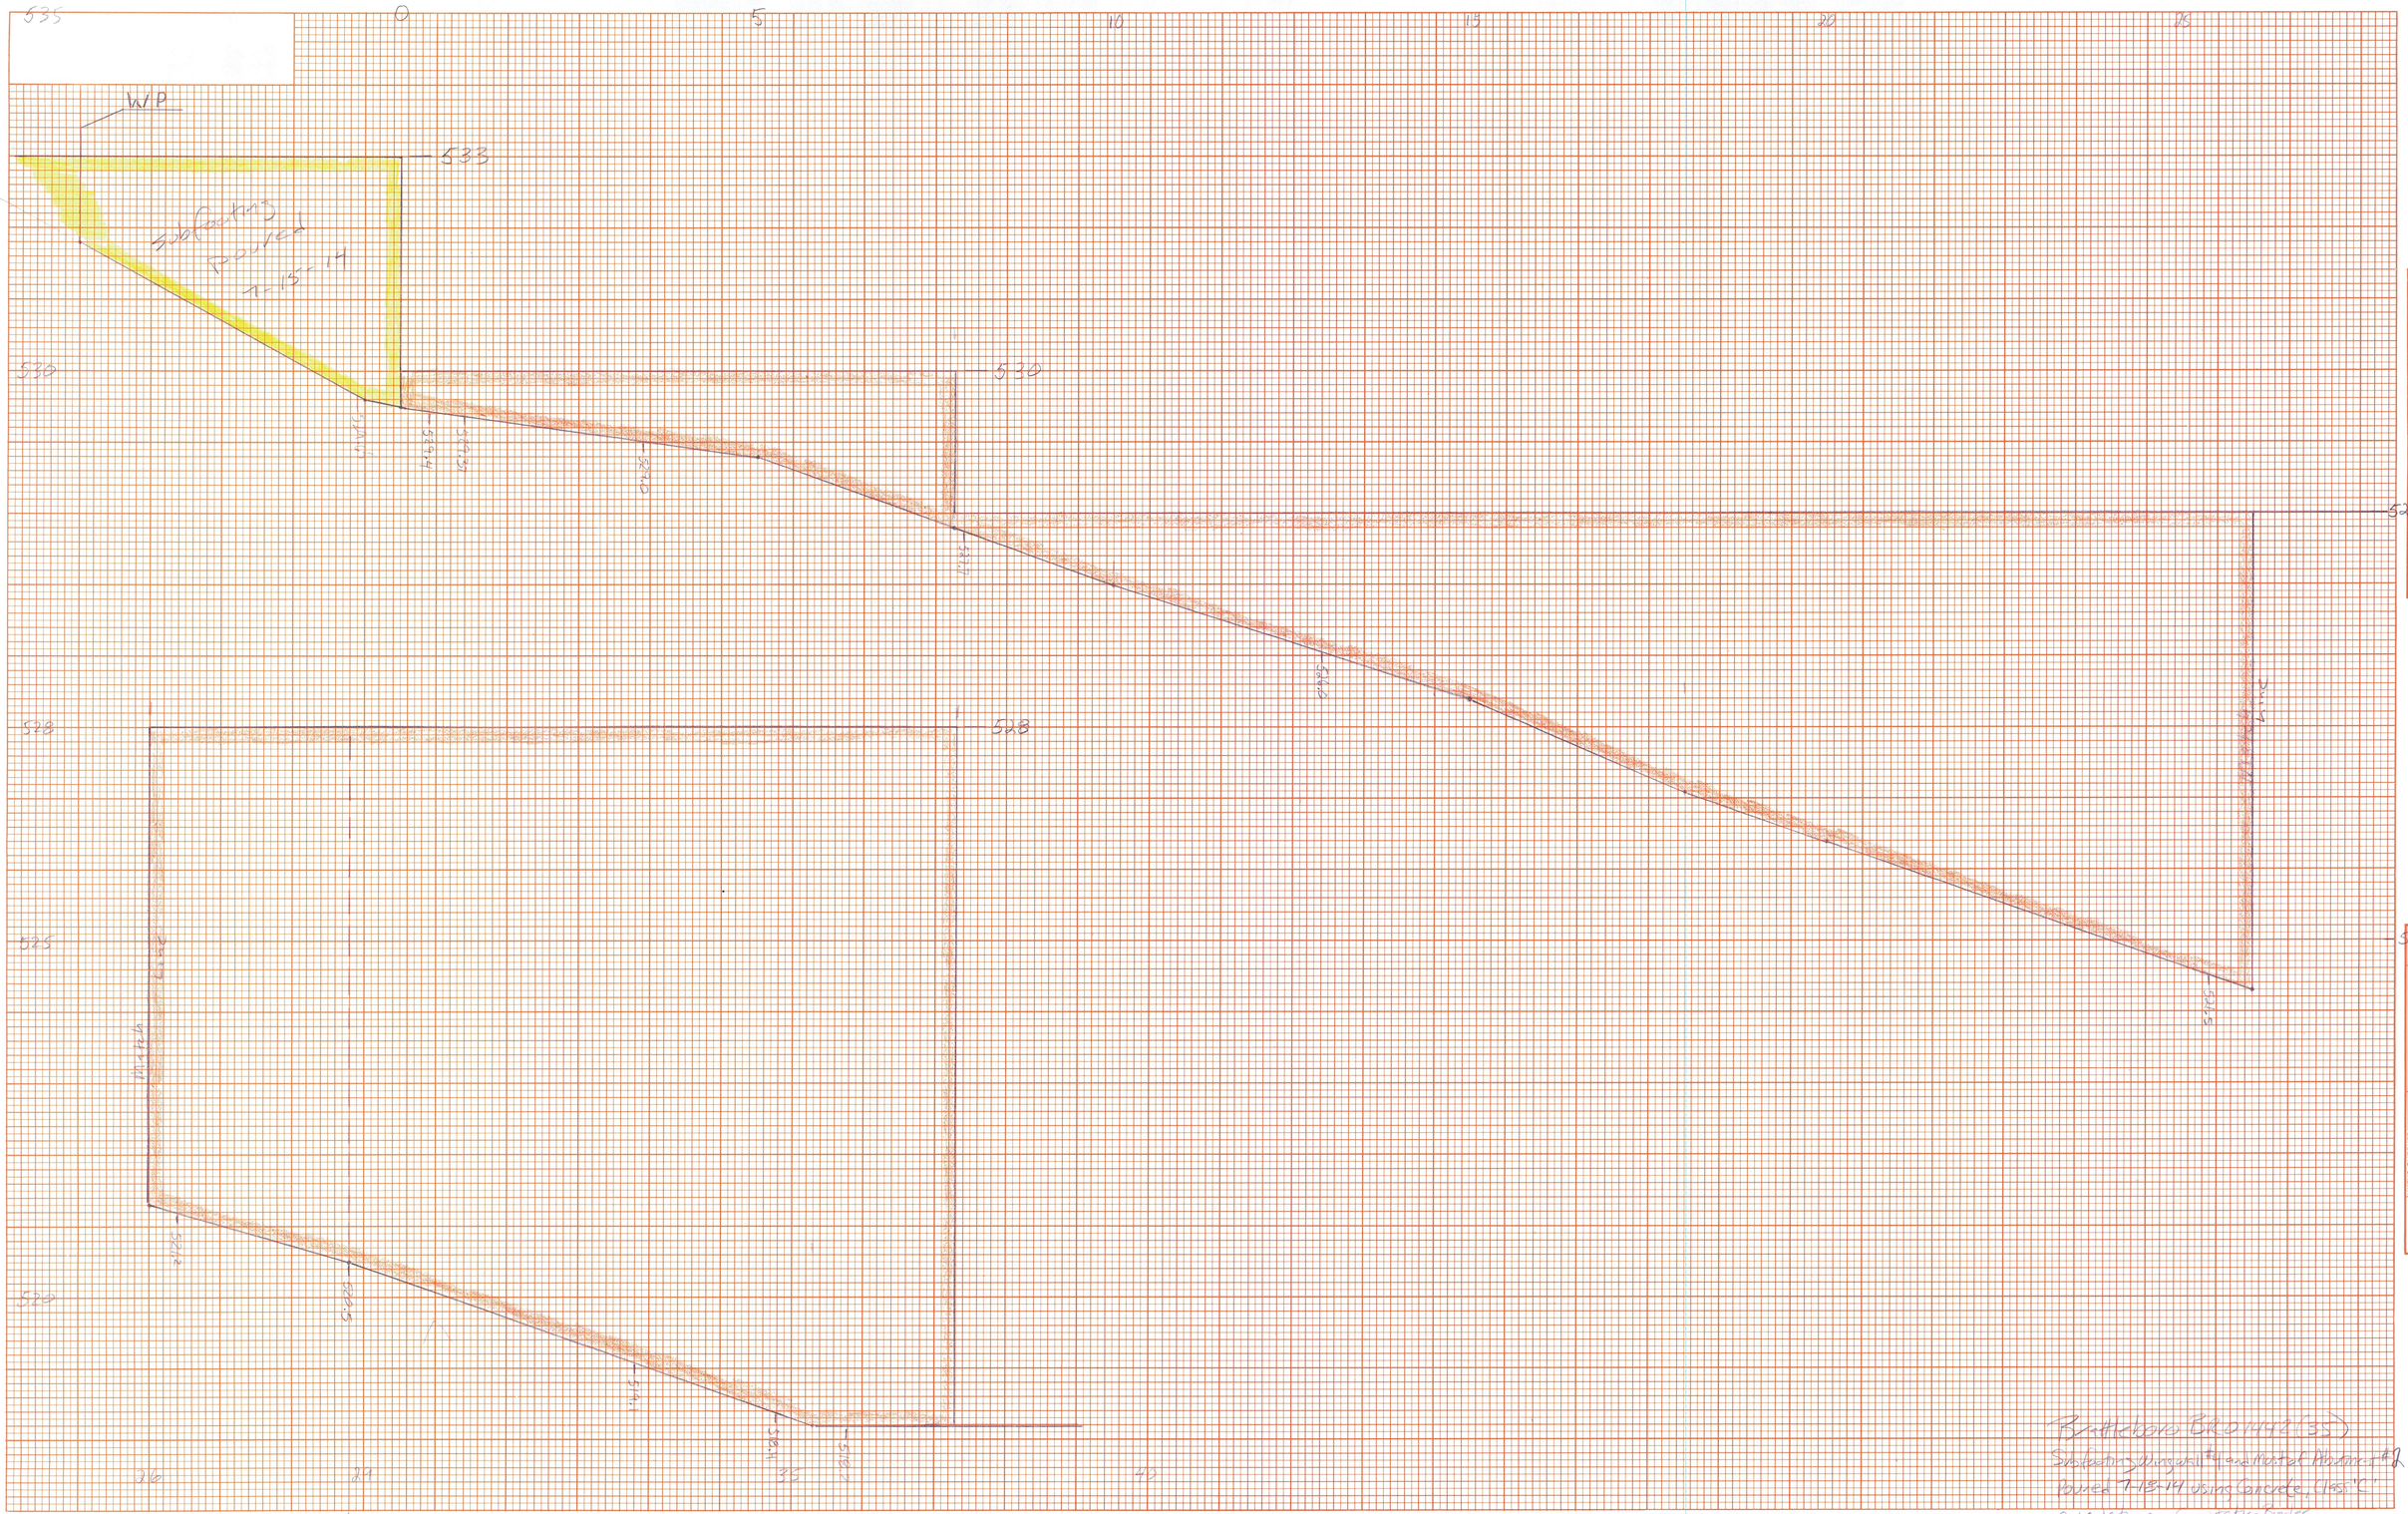

Bradford Bridge (55)
Substructure Wingwall #4 and Most of Abutment #2
Poured 7-15-14 using Concrete Class "C"
Calculations in Computation Book

NO.	VALVE CHECKED				
	NOTE BOOK	NAME			
	SURVEY	STAMPED			
		NOTED			
		DETAILED			
ORIGINAL		ESTIMATED	BA.	DATE	

NO.	VALVE CHECKED				
	NOTE BOOK	NAME			
	SURVEY	STAMPED			
		NOTED			
		DETAILED			
	HUNT	ESTIMATED	BA.	DATE	

HIGHWAY FEDERAL AID SHEET
PLATE 3-FULL CROSS SECTION-FULL LINE
NATIONAL PRINTWEST
PRINTED IN U.S.A.