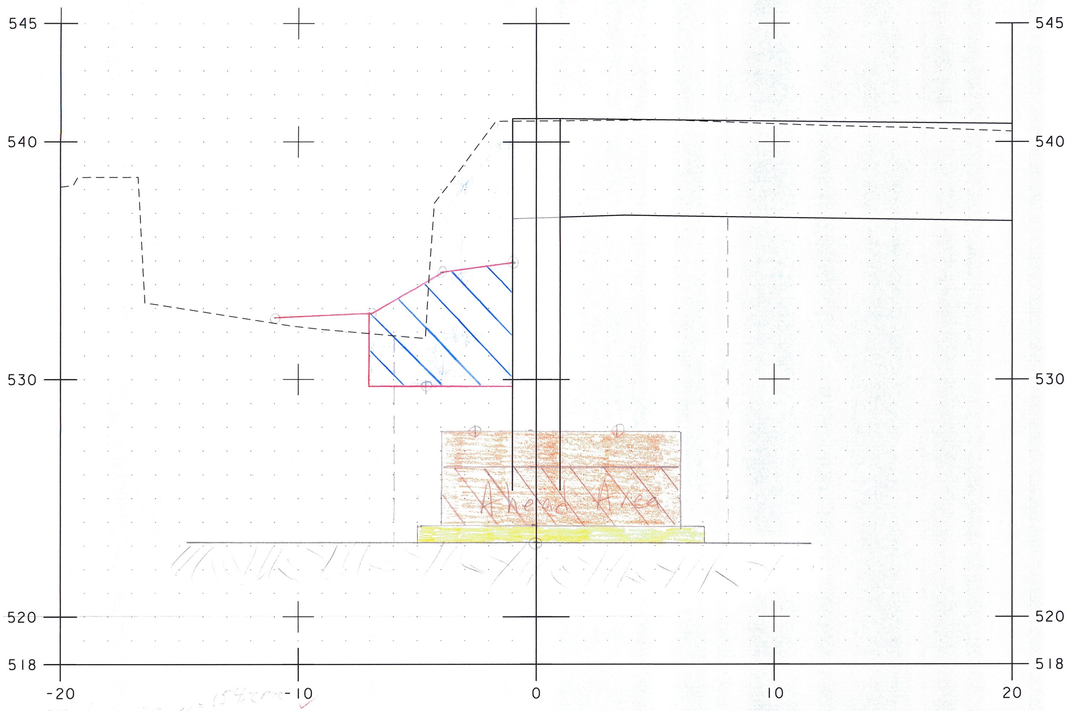

40+03.70

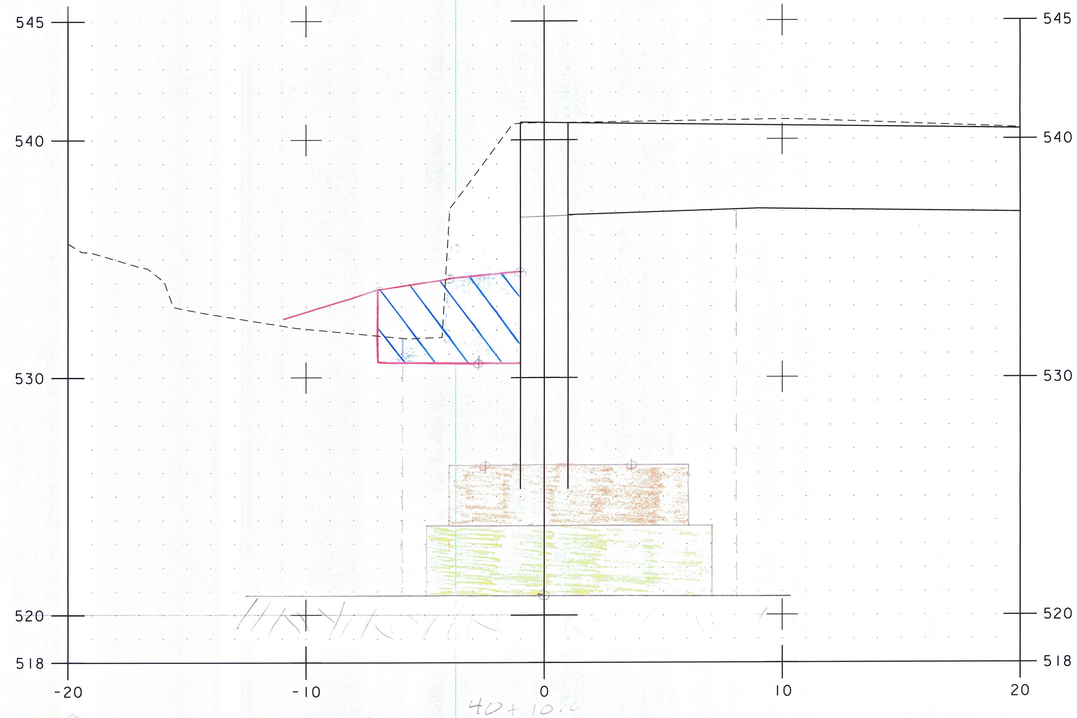

40+09.00

NOTE: LOCATION OF SUBBASE IS APPROXIMATE.

SCALE 1" = 3'-0"

PROJECT NAME:	BRATTLEBORO
PROJECT NUMBER:	BRO 1442(35)

FILE NAME: z10J062_customEL.dgn	PLOT DATE: 3/2/2015
PROJECT LEADER: S.E. BURBANK	DRAWN BY: E.F. LAWES
DESIGNED BY: E.F. LAWES	CHECKED BY: S.E. BURBANK
ABUTMENT NO. 1 CROSS SECTIONS (6 OF 7)	SHEET 22 OF 28

VHB 57428