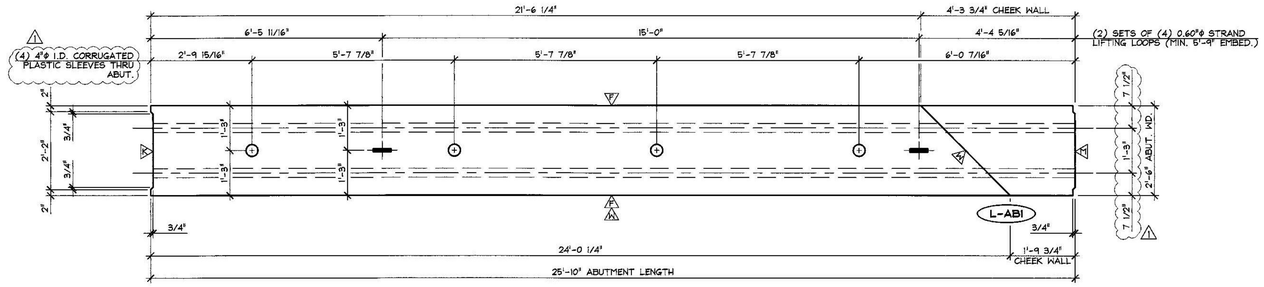

DIMENSIONAL PLAN VIEW IN FORM

1/2" = 1'-0"

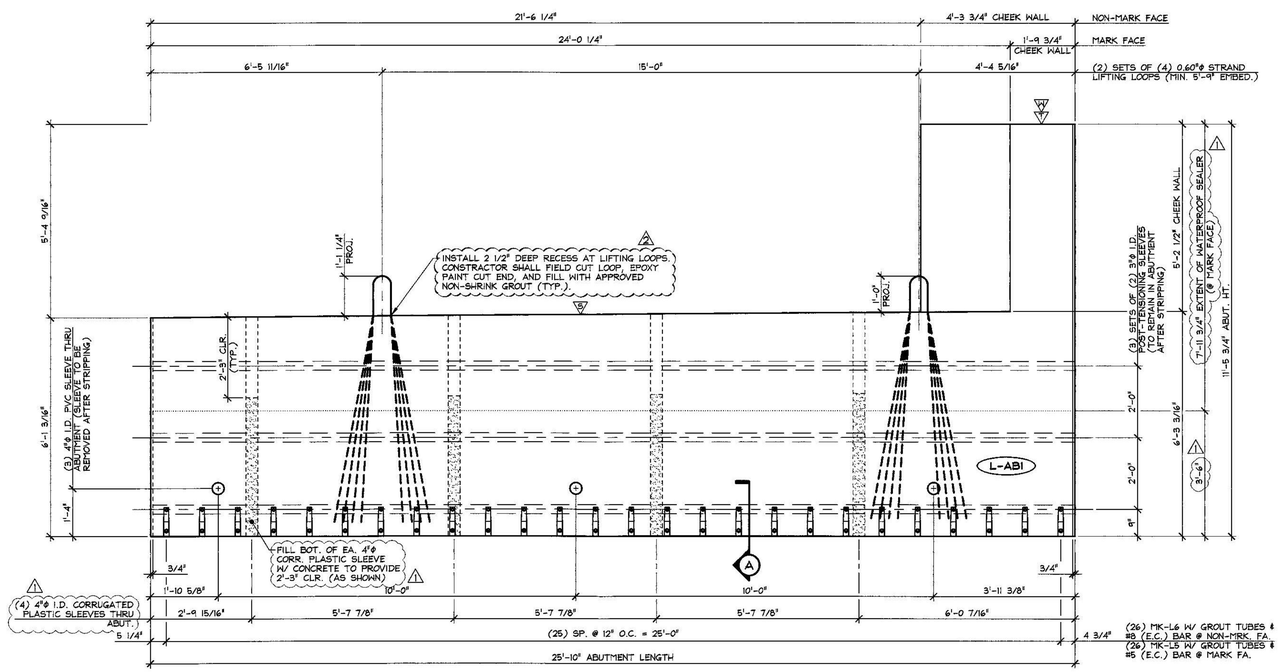

MARK FACE ELEVATION

1/2" = 1'-0"

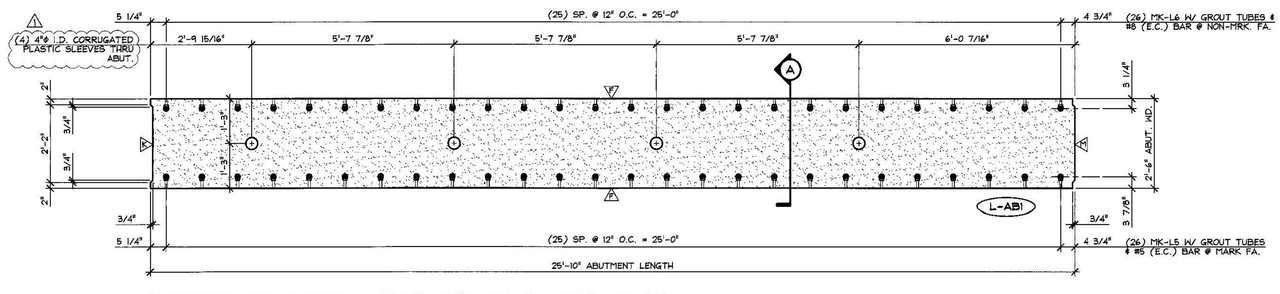

BOTTOM OF FORM - NMB SPLICE SLEEVE PLAN

1/2" = 1'-0"

Vermont Agency of Transportation

RECEIVED

ON: May 12, 2015

and Checked for

CONFORMANCE

BY: Todd A. Sumner DATE: 05/13/2015

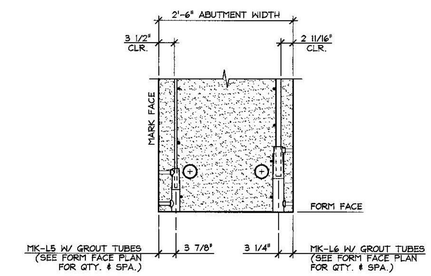

A SPLICE SLEEVE DETAIL

3/4" = 1'-0"

△6 DENOTES SMOOTH SCREED FINISH

△4 DENOTES (1) COAT WATERPROOF SEALER

△3 DENOTES FORM FINISH

△5 DENOTES ROUGHENED FINISH

△1 DENOTES STEEL TROWEL FINISH

△2 DENOTES MATCH CAST

SHOP NOTE:
f'c = 5,000 PSI
f'ci = 3,500 PSI
MIX #445MSCC

SUBMITTAL REVIEW

Review is only for general conformity to the contract drawings and specifications and shall not relieve the contractor of his entire responsibility under the contract, including among other things, dimensions to be confirmed and correlated at the job site, and information that pertains to the fabrication processes or to techniques of construction.

☑ NO EXCEPTIONS TAKEN
☐ MAKE CORRECTIONS NOTED RESUBMITTAL NOT REQUIRED
☐ AMEND AND RESUBMIT
☐ REJECTED - SEE REMARKS

PB AMERICAS, INC.
BY: Ray L. Fiore
DATE: 5/12/2015

△2 5-11-15 REVISED AS NOTED

△1 4-27-15 GENERAL REVISIONS

MARK: L-AB1	QTY.: 1	WT.: 32.88 T	VOL.: 16.24 cy

MATERIAL LIST / ABUTMENT

ITEM	MARK	DESCRIPTION	QTY.
1	MK-L5	NMB SPLICE SLEEVE 5U-X(PG) (EPOXY COATED)	26
2	MK-L6	NMB SPLICE SLEEVE 8U-X(PG) (EPOXY COATED)	26
3			
4		SET OF (4) 0.60"ϕ STRAND LIFTING LOOPS	2
5			
6	△1	4"ϕ I.D. x 6'-3" CORRUGATED PLASTIC SLEEVE	4
7			
8			
9			
10			

APPROVAL STAMP:

J.P. CARRARA & SONS INC.
Precast & Prestress Manufacturer
2464 CASE STR., MIDDLEBURY, VERMONT 05753 Phone:(802)388-6361 Fax:(802)388-9010

J.A. McDONALD, INC.
CONTRACTOR
LYNDON CENTER, VERMONT

STATE OF VERMONT AGENCY OF TRANSPORTATION
COUNTY OF ADDISON

DATE: FEB. 6, 2015
SCALE: NOTED

TOWN OF LINCOLN
TH 1 (RURAL MAJOR COLLECTOR) OVER NEW HAVEN RIVER
BRIDGE NO.: 19 PROJECT NO.: BRF 0188 (8)

CHKD: M.W. DFTM: B.L.
JOB NO: 23459-015

PRECAST ABUTMENT
DIMENSIONAL DETAILS

DWG. NO: AB1

F:\VT-Bridges\23459-15 Lincoln Bridge 19\23459-AB1.dwg, 5/11/2015 1:09:11 PM