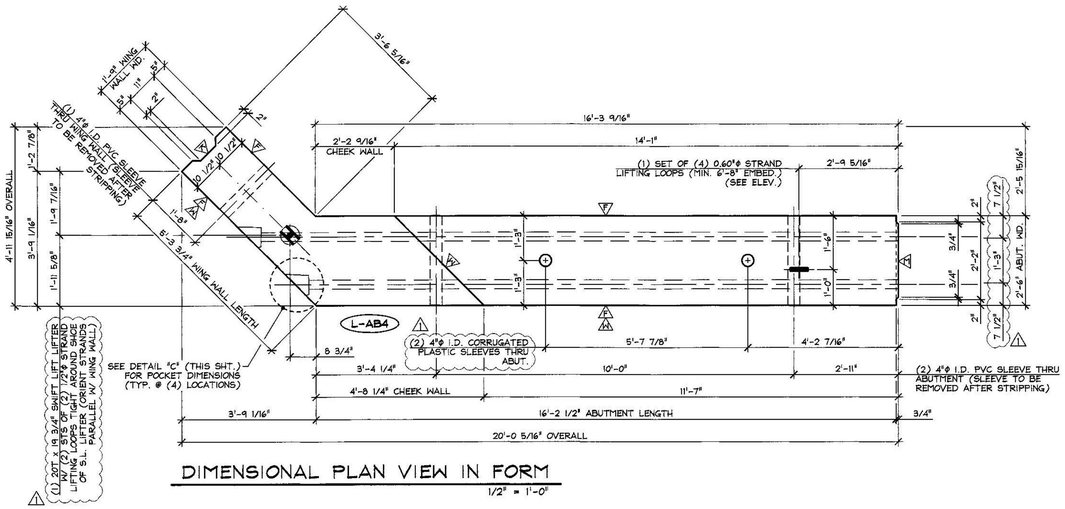

DIMENSIONAL PLAN VIEW IN FORM
1/2" = 1'-0"

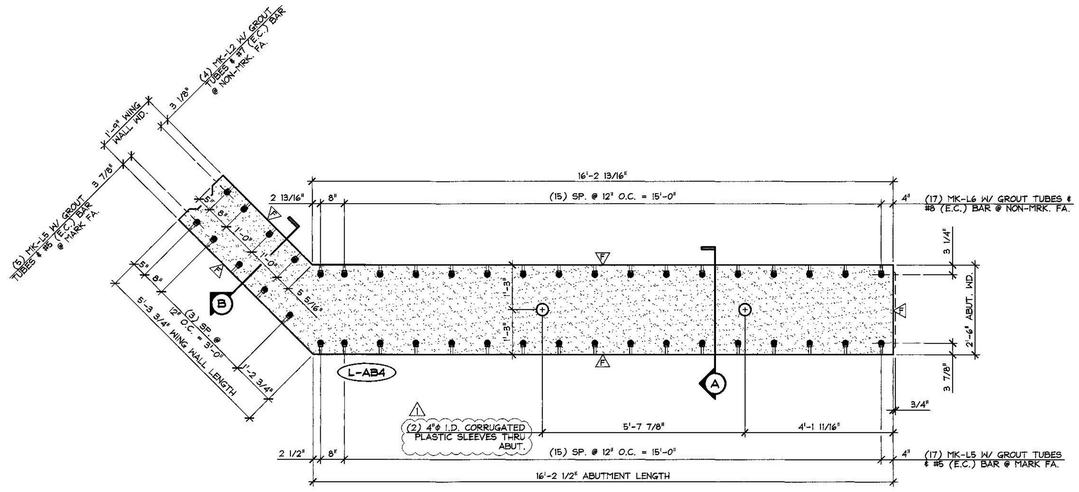

BOTTOM OF FORM - NMB SPLICE SLEEVE PLAN
1/2" = 1'-0"

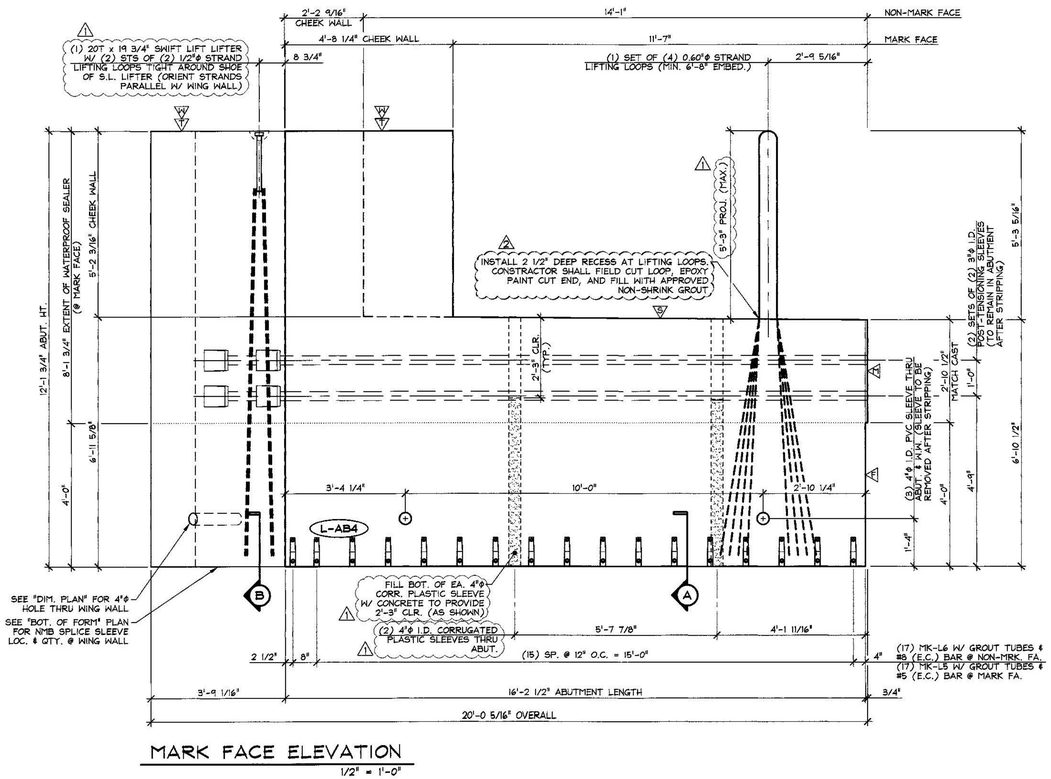

MARK FACE ELEVATION
1/2" = 1'-0"

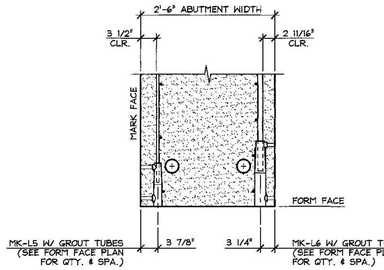

A SPLICE SLEEVE DETAIL
3/4" = 1'-0"

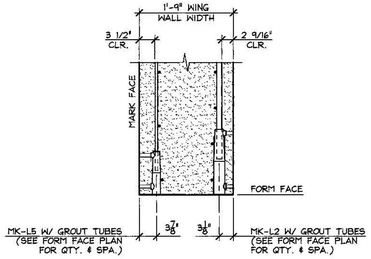

B SPLICE SLEEVE DETAIL
3/4" = 1'-0"

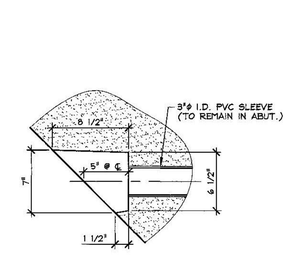

C P.T. POCKET DETAIL
1 1/2" = 1'-0"

Vermont Agency of Transportation

RECEIVED
ON: May 12, 2015
and Checked for
CONFORMANCE
BY: Todd A. Sumner DATE: 05/13/2015

SUBMITTAL REVIEW
Review is only for general conformity to the contract drawings and specifications and shall not relieve the contractor of his entire responsibility under the contract, including among other things, dimensions to be confirmed and correlated at the job site, and information that pertains to the fabrication processes or to techniques of construction.
☑ NO EXCEPTIONS TAKEN
☐ MAKE CORRECTIONS NOTED
RESUBMITTAL NOT REQUIRED
☐ AMEND AND RESUBMIT
☐ REJECTED - SEE REMARKS
PB AMERICAS, INC.
BY: Ray L. Jones
DATE: 5/12/2015

△ DENOTES ROUGHENED FINISH
△ DENOTES SMOOTH SCREED FINISH
△ DENOTES STEEL TROWEL FINISH
△ DENOTES (1) COAT WATERPROOF SEALER
△ DENOTES MATCH CAST
△ DENOTES FORM FINISH

△ SHOP NOTE:
f'c = 5,000 PSI
f'ci = 5,000 PSI
MIX #448MSCC

MARK: L-AB4	QTY.: 1	WT.: 31.38 T	VOL.: 15.50 cy

MATERIAL LIST / ABUTMENT

ITEM	MARK	DESCRIPTION	QTY.
1	MK-L2	NMB SPLICE SLEEVE 7U-X(PG) (EPOXY COATED)	4
2	MK-L5	NMB SPLICE SLEEVE 5U-X(PG) (EPOXY COATED)	22
3	MK-L6	NMB SPLICE SLEEVE 8U-X(PG) (EPOXY COATED)	17
4			
5		20T x 19 3/4" SWIFT LIFT LIFTER (GALV.)	1
6		SET OF (2) 1/2"ø STRAND LIFTING LOOPS	2
7		SET OF (4) 0.60"ø STRAND LIFTING LOOPS	1
8			
9	△1	4"ø I.D. x 6'-11" CORRUGATED PLASTIC SLEEVE	2
10			

△ 5-11-15 REVISED AS NOTED
△ 4-27-15 GENERAL REVISIONS

APPROVAL STAMP:

J.P. CARRARA & SONS INC.
Precast & Prestress Manufacturer
2464 CASE STR., MIDDLEBURY, VERMONT 05753 Phone:(802)388-6361 Fax:(802)388-9010

J.A. McDONALD, INC.
CONTRACTOR
LYNDON CENTER, VERMONT

STATE OF VERMONT AGENCY OF TRANSPORTATION
COUNTY OF ADDISON

TOWN OF LINCOLN
TH 1 (RURAL MAJOR COLLECTOR) OVER NEW HAVEN RIVER
BRIDGE NO.: 19 PROJECT NO.: BRF 0188 (8)

PRECAST ABUTMENT
DIMENSIONAL DETAILS

DATE: FEB. 6, 2015
SCALE: NOTED
CHKD: M.W. DFTM: B.L.
JOB NO: 23459-015
DWG. NO: AB4

F:\VT-Bridges\23459-15 Lincoln Bridge 19\23459-AB4.dwg, 5/11/2015 1:24:33 PM