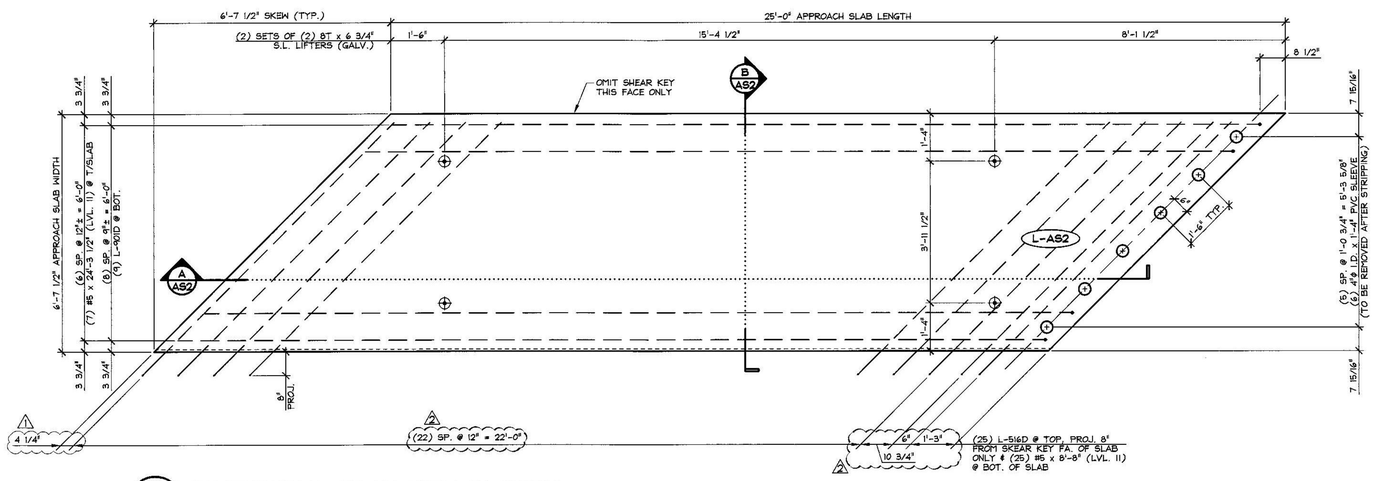

1 / AS2 DIMENSIONAL PLAN VIEW IN FORM
1/2" = 1'-0"

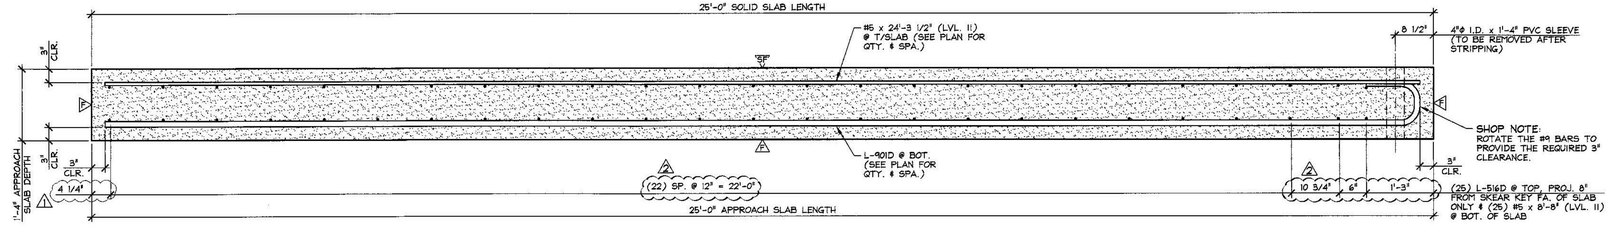

A / AS2 LONGITUDINAL SECTION
3/4" = 1'-0"

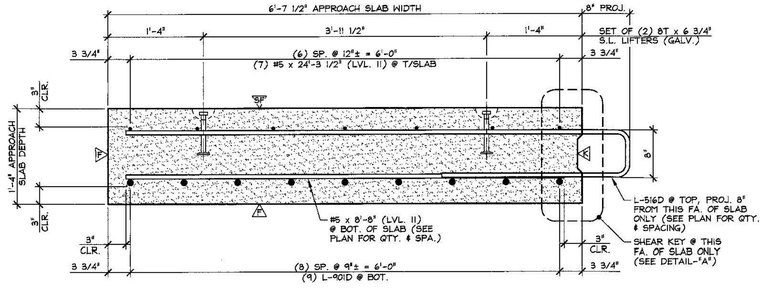

B / AS2 LONGITUDINAL SECTION
1" = 1'-0"

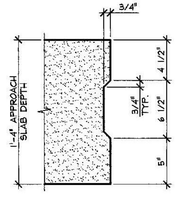

DETAIL - "A"
1 1/2" = 1'-0"

Vermont Agency of Transportation

RECEIVED
ON: May 12, 2015
and Checked for
CONFORMANCE
BY: Todd A. Sumner DATE: 05/13/2015

SUBMITTAL REVIEW

Review is only for general conformity to the contract drawings and specifications and shall not relieve the contractor of his entire responsibility under the contract, including among other things, dimensions to be confirmed and correlated at the job site, and information that pertains to the fabrication processes or to techniques of construction.

- ☑ NO EXCEPTIONS TAKEN
- ☐ MAKE CORRECTIONS NOTED RESUBMITTAL NOT REQUIRED
- ☐ AMEND AND RESUBMIT
- ☐ REJECTED - SEE REMARKS

PB AMERICAS, INC.
BY: Ray-Lee Jones
DATE: 5/12/2015

△ DENOTES FORM FINISH
△ DENOTES SMOOTH FLOAT FINISH
△ DENOTES ROUGHENED FINISH

SHOP NOTE:
f'c = 5,000 PSI
f'ci = 3,500 PSI
MIX #445MSCC

MARK: L-AS2	QTY.: 2	WT.: 16.51 T	VOL.: 8.15 cy

MATERIAL LIST / APPROACH SLAB

ITEM	MARK	DESCRIPTION	QTY.
1	L-516D	#5 BENT BAR (LEVEL II, DUAL COATED)	25
2		#5 x 8'-8" (LEVEL II, DUAL COATED)	25
3		#5 x 24'-3 1/2" (LEVEL II, DUAL COATED)	7
4			
5	L-90ID	#9 BENT BAR (LEVEL II, DUAL COATED)	9
6			
7			
8		4"ø I.D. x 1'-4" PVC SLEEVE	6
9		8T x 6 3/4" SWIFT LIFT LIFTER (GALV.)	4
10			

△2 5-11-15 REVISED AS NOTED
△1 4-27-15 GENERAL REVISIONS

APPROVAL STAMP:

J.P. CARRARA & SONS INC.
Precast & Prestress Manufacturer
2464 CASE STR., MIDDLEBURY, VERMONT 05753 Phone:(802)388-6361 Fax:(802)388-9010

J.A. McDONALD, INC.
CONTRACTOR
LYNDON CENTER, VERMONT

STATE OF VERMONT AGENCY OF TRANSPORTATION
COUNTY OF ADDISON

DATE: FEB. 6, 2015
SCALE: NOTED

TOWN OF LINCOLN
TH 1 (RURAL MAJOR COLLECTOR) OVER NEW HAVEN RIVER
BRIDGE NO.: 19 PROJECT NO.: BRF 0188 (8)

CHKD: M.W. DFTM: B.L.
JOB NO: 23459-015

PRECAST APPROACH SLAB DETAILS

DWG. NO: AS2

F:\VT-Bridges\23459-15 Lincoln Bridge 19\23459-AS2.dwg, 5/11/2015 1:46:35 PM