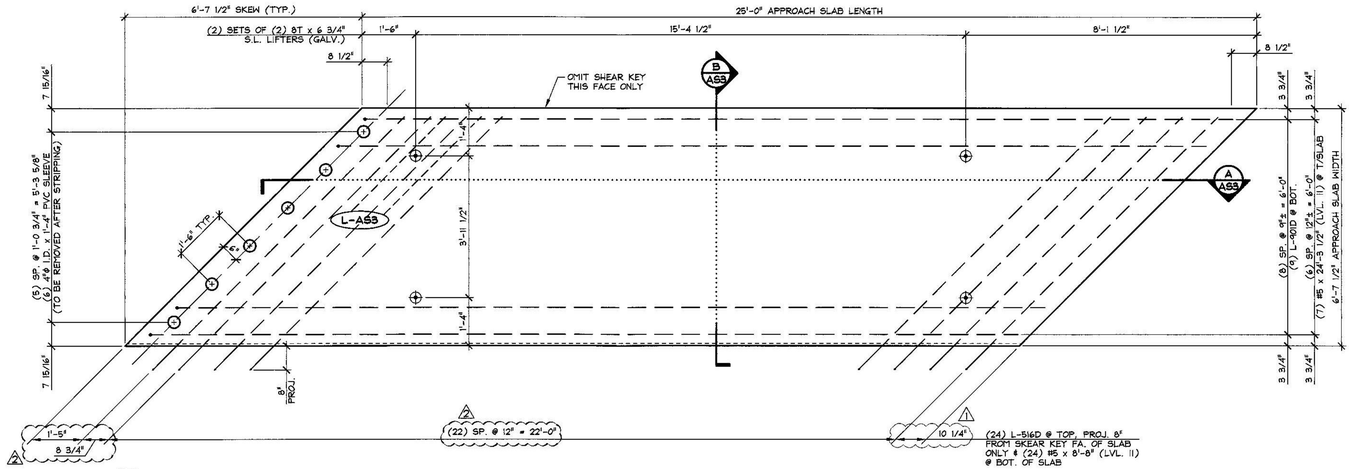

1 AS3 DIMENSIONAL PLAN VIEW IN FORM

1/2" = 1'-0"

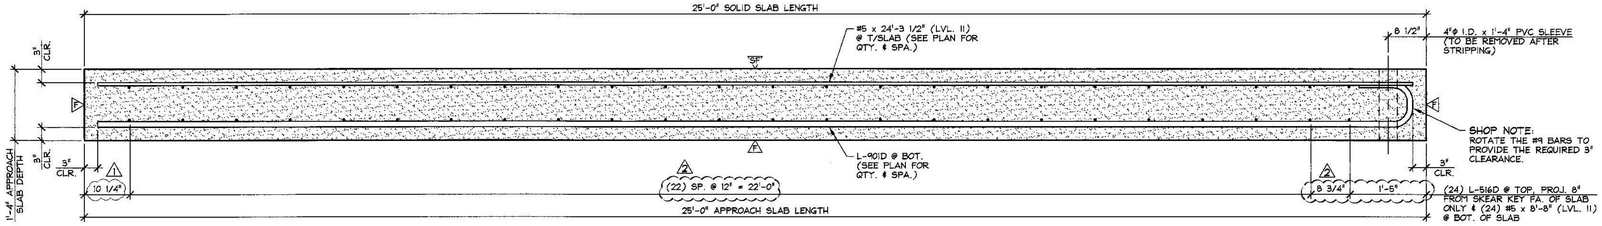

A AS3 LONGITUDINAL SECTION

3/4" = 1'-0"

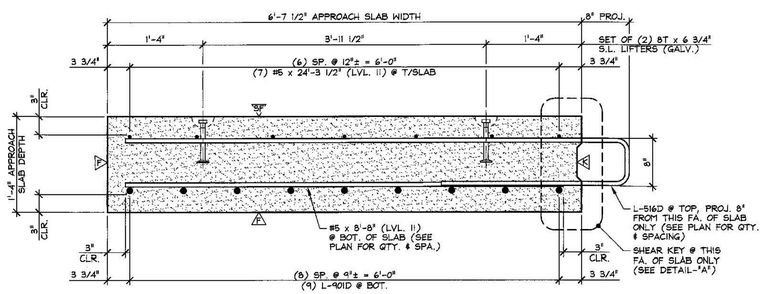

B AS3 LONGITUDINAL SECTION

1" = 1'-0"

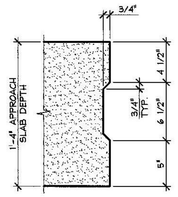

DETAIL - "A"

1 1/2" = 1'-0"

SUBMITTAL REVIEW

Review is only for general conformity to the contract drawings and specifications and shall not relieve the contractor of his entire responsibility under the contract, including among other things, dimensions to be confirmed and correlated at the job site, and information that pertains to the fabrication processes or to techniques of construction.

- [x] NO EXCEPTIONS TAKEN
- [ ] MAKE CORRECTIONS NOTED RESUBMITTAL NOT REQUIRED
- [ ] AMEND AND RESUBMIT
- [ ] REJECTED - SEE REMARKS

PB AMERICAS, INC.
BY: Ravi K. Jain
DATE: 5/12/2015

Vermont Agency of Transportation

RECEIVED
ON: May 12, 2015
and Checked for
CONFORMANCE
BY: Todd A. Sumner DATE: 05/13/2015

△ DENOTES FORM FINISH
△ DENOTES SMOOTH FLOAT FINISH
△ DENOTES ROUGHENED FINISH

SHOP NOTE:
f'c = 5,000 PSI
f'ci = 3,500 PSI
MIX #445MSCC

MARK: L-AS3	QTY.: 2	WT.: 16.51 T	VOL.: 8.15 cy

MATERIAL LIST / APPROACH SLAB

ITEM	MARK	DESCRIPTION	QTY.
1	L-516D	#5 BENT BAR (LEVEL II, DUAL COATED)	24
2		#5 x 8'-8" (LEVEL II, DUAL COATED)	24
3		#5 x 24'-3 1/2" (LEVEL II, DUAL COATED)	7
4			
5	L-901D	#9 BENT BAR (LEVEL II, DUAL COATED)	9
6			
7			
8		4"ø I.D. x 1'-4" PVC SLEEVE	6
9		8T x 6 3/4" SNIFT LIFT LIFTER (GALV.)	4
10			

△ 5-11-15 REVISED AS NOTED
△ 4-27-15 GENERAL REVISIONS

APPROVAL STAMP:

J.P. CARRARA & SONS INC.
Precast & Prestress Manufacturer
2464 CASE STR., MIDDLEBURY, VERMONT 05753 Phone:(802)388-6361 Fax:(802)388-9010

J.A. McDONALD, INC.
CONTRACTOR
LYNDON CENTER, VERMONT

STATE OF VERMONT AGENCY OF TRANSPORTATION
COUNTY OF ADDISON

TOWN OF LINCOLN
TH 1 (RURAL MAJOR COLLECTOR) OVER NEW HAVEN RIVER
BRIDGE NO.: 19 PROJECT NO.: BRF 0188 (8)

PRECAST APPROACH SLAB DETAILS

DATE: FEB. 6, 2015
SCALE: NOTED
CHKD: M.W. DFTM: B.L.
JOB NO: 23459-015
DWG. NO: AS3

F:\VT-Bridges\23459-15 Lincoln Bridge 19\23459-AS3.dwg, 5/11/2015 1:54:42 PM