ABM INFO PAGE	ABM INFO LINE	SHIP MARK	QTY	MARK	MATERIAL	LENGTH FT	LENGTH INCHES	REMARKS	WT	PROCUREMENT NOTES
		2G2A	1		GIRDER			METALIZED	21020	
2	A		1	wa	PL $\frac{5}{8}$x30	75	$10\frac{3}{4}$	M270-50T2	4842	
1	Q		1	ta	PL $1\frac{3}{4}$x16	75	$10\frac{7}{16}$	M270-50T2	7229	
1	E		1	ba	PL 2x16	75	$10\frac{1}{2}$	M270-50T2	8262	
4	C		2	x2a	PL $\frac{3}{4}$x$7\frac{1}{2}$	2	6	MIC M270-50T2	48	
4	D		8	x2b	PL $\frac{1}{2}$x$7\frac{1}{2}$	2	6	M270-50T2	32	
5	D		254		STUD $\frac{7}{8}\phi$	0	7	STUDS A108	1	

BILL OF MATERIAL — JOB NO. 645 — DRAWING NO. 2 — REV. 2

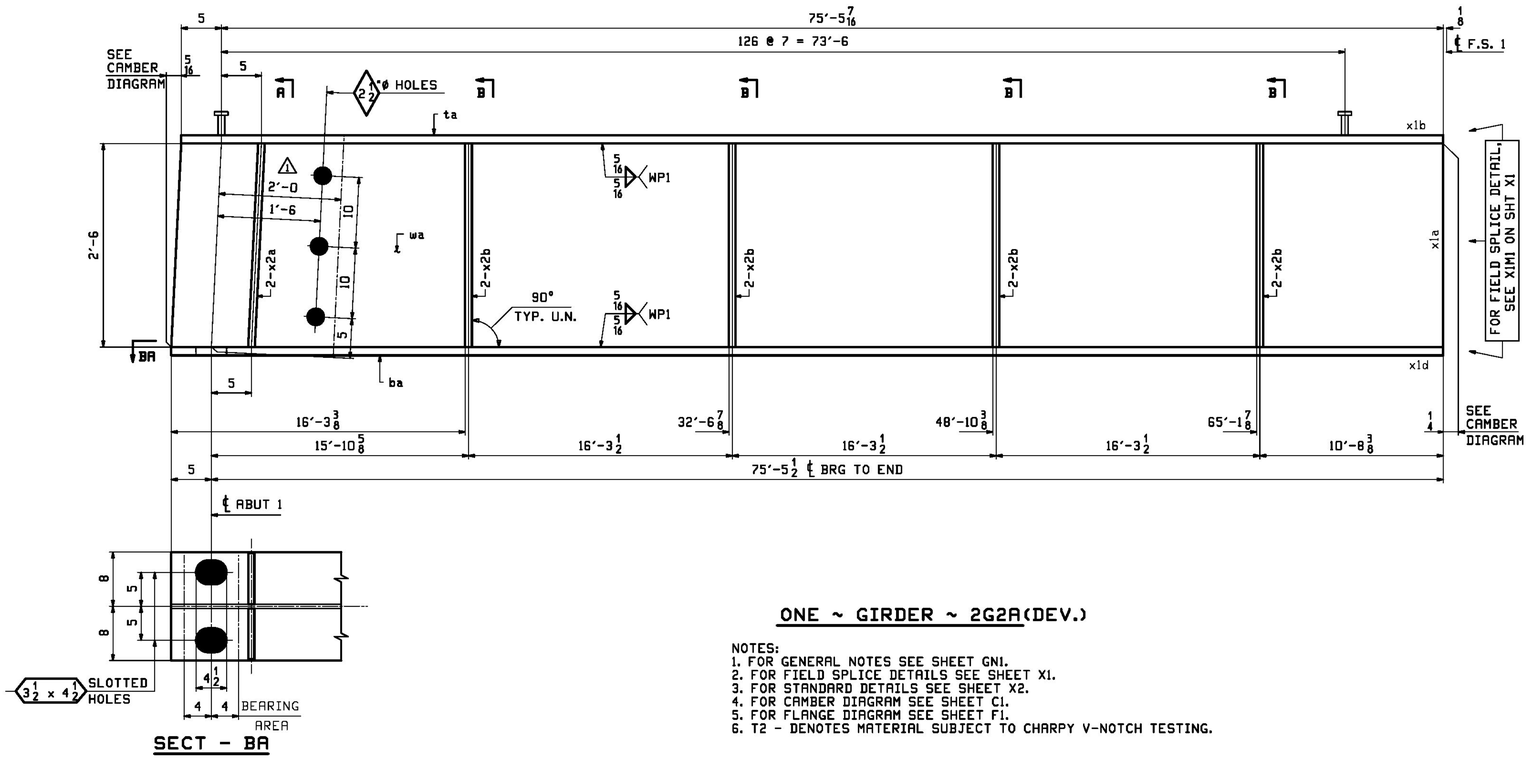

ONE ~ GIRDER ~ 2G2A(DEV.)

NOTES:
1. FOR GENERAL NOTES SEE SHEET GN1.
2. FOR FIELD SPLICE DETAILS SEE SHEET X1.
3. FOR STANDARD DETAILS SEE SHEET X2.
4. FOR CAMBER DIAGRAM SEE SHEET C1.
5. FOR FLANGE DIAGRAM SEE SHEET F1.
6. T2 - DENOTES MATERIAL SUBJECT TO CHARPY V-NOTCH TESTING.

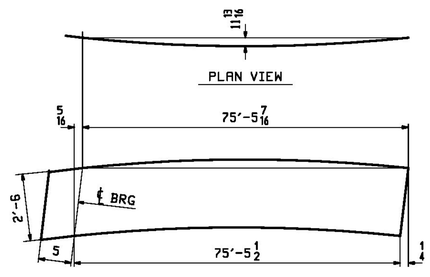

DEV. ORIENTATION DIAGRAM

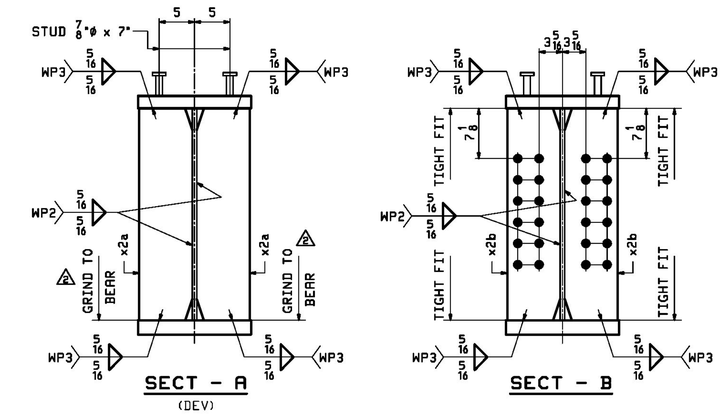

REV.	DATE	REMARKS	DWN	CHK	APVL	SHOP
2	1/20 2016	APPROVAL COMMENTS	LWD	WJL		
1	12/9	APPROVAL COMMENTS	LWD	WJL		
0						

MATERIAL:	SURFACE PREP. & PAINT:	HOLES:	SHOP BOLTS:
M270-50T2 UN.	SEE GN1	$\frac{15}{16}\phi$ UN.	NONE

DESCRIPTION: GIRDER - 2G2A

CASCO BAY STEEL STRUCTURES, INC.
1 WALLACE AVE. SOUTH PORTLAND, ME 04106
PHONE (207) 780-6722 FAX. (207) 780-6726
TENSOR 3354

STRUCTURE:
TH-2 (RIVER ROAD)
BRIDGE #10
COUNTY OF ADDISON

DRAWN: LWD	DATE: 10/21		
CHKD: WJL	DATE: 10/27		
LOCATION: TOWN OF NEW HAVEN, VT	JOB NO. 645	DWG NO. 2	
PROJ NO. BRF 0183 (1)		REV. 2	
CUSTOMER: CCS CONSTRUCTORS, INC.			

WJL Thu, Jan 21, 2016 03:05:03 PM /users/jobs/2354/2.1.Rev2