STATE OF VERMONT
AGENCY OF TRANSPORTATION

TRAFFIC SIGN SUMMARY SHEET 6 - BARTON

DIRECTION	MILEMARKER, STATION, OR SIGN NUMBER	LOCATION	MANUAL ON UNIFORM TRAFFIC DEVICES OR STATE CODE	SIGN DIMENSIONS WIDTH	SIGN DIMENSIONS HEIGHT	SHEETING REMARKS	SIGN LEGEND	NEW SIGNS "A"	NEW SIGNS "B"	EXISTING SIGNS RETAIN	EXISTING SIGNS SALVAGE FROM	EXISTING SIGNS SALVAGE TO	EXISTING SIGNS REMOVE	EXISTING POST RETAIN	EXISTING POST REMOVE	NO. OF NEW POSTS	SQUARE STEEL (in) 1.75 lb/ft 1.88	SQUARE STEEL (in) 2.00 lb/ft 2.42	SQUARE STEEL (in) 2.50 lb/ft 3.35	TUBULAR STEEL O/(in) FOUNDATION	TUBULAR STEEL O/(in) 3.00 lb/ft 7.60	TUBULAR STEEL O/(in) 3.50 lb/ft 9.00	TUBULAR STEEL O/(in) 4.00 lb/ft 10.80	TUBULAR STEEL O/(in) 5.00 lb/ft 14.60	SIGN FRAME REQUIRED	REMARKS SHS = STANDARD HIGHWAY SIGN BOOK	SIGN DETAIL IN SHS	SIGN DETAIL ON SHEET NUMBER	SIGN DETAIL STANDARD SHEET NUMBER
SB	MM 4.470, ~~RT~~ LT TO MM 4.481, ~~RT~~ LT	F E		6	8		(8) TYPE II - 6" X 8" WHITE DELINEATORS																			INSTALL NEW DELINEATORS (8) BACK-TO-BACK 20 FT APART ON 4 POSTS, INSTALL FIRST 52 FT SOUTH OF POLE #133		6	
NB	MM 4.880, RT	A	WI-2R	30	30			6.25					~~X~~ ALREADY GONE		~~X~~	1		X								REPLACE EXISTING SIGN AND POST 100 FT NORTH OF POLE #16/144	X		
		A	WI3-IP	18	18			2.25																		INSTALL NEW PLAQUE BELOW WI-2R SIGN ON THE SAME POST	X		
SB	MM 4.900, LT TO MM 4.980, LT	F E		6	8		(10) TYPE II - 6" X 8" WHITE DELINEATORS																			INSTALL NEW DELINEATORS (10) BACK-TO-BACK 85 FT APART ON 5 POSTS, INSTALL FIRST ACROSS FROM POLE *B/311/20/145		6	
SB	MM 5.010, LT	F	WI-2L	30	30			6.25								1		X								INSTALL NEW SIGN AND POST 100 FT SOUTH AND ACROSS FROM POLE *B/311/20/148	X		
		F	WI3-IP	18	18			2.25																		INSTALL NEW PLAQUE BELOW WI-2L SIGN ON THE SAME POST	X		
NB	MM 5.230, RT TO MM 5.280, RT	A B		6	8		(6) TYPE II - 6" X 8" WHITE DELINEATORS																			INSTALL NEW DELINEATORS (6) BACK-TO-BACK 85 FT APART ON 3 POSTS, INSTALL FIRST 106 FT SOUTH OF POLE B/311/20/152		6	
NB	MM 5.930, RT	A	WI-4L	30	30			6.25								1		X								INSTALL NEW SIGN AND POST 158 FT NORTH AND ACROSS FROM POLE *22/NET/10-8/23	X		
		A	WI3-IP	18	18			2.25																		INSTALL NEW PLAQUE BELOW WI-4L SIGN ON THE SAME POST	X		
NB	MM 6.210, RT	A	R2-5A	24	30								X		X											REMOVE EXISTING SIGN AND POST 158 FT SOUTH AND ACROSS FROM POLE #4			
SB	MM 6.210, LT	F	WI-4L	30	30			6.25								1		X								INSTALL NEW SIGN AND POST 158 FT SOUTH OF POLE #4	X		
		F	WI3-IP	18	18			2.25																		INSTALL NEW PLAQUE BELOW WI-4L SIGN ON THE SAME POST	X		
NB	MM 6.250, RT	A	W3-5	36	36			9.00								2		X								INSTALL NEW SIGN ON 2 POSTS 53 FT NORTH AND ACROSS FROM POLE #4	X		
NB	MM 6.310, RT	A	VD-024	72	10		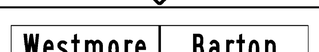	5.00								2		X								INSTALL NEW SIGN ON 2 POSTS AT WESTMORE AND BARTON TOWN LINE 370 FT NORTH OF AND ACROSS FROM POLE #4		7	
NB	MM 6.310, RT	A	R2-1	24	30			5.00					X		X	1		X								REPLACE EXISTING SIGN AND POST ON WESTMORE AND BARTON TOWN LINE 370 FT NORTH OF POLE #4	X		
SB	MM 6.310, LT	F	R2-1	24	30			5.00								1		X								INSTALL NEW SIGN AND POST ON THE WESTMORE AND BARTON TOWN LINE, ACROSS THE ROAD FROM THE TOWN LINE SIGN 370 FT NORTH OF POLE #4	X		
										EA	EA	EA	EA ~~3~~ 2	EA	EA ~~3~~ 2		FT	FT 150	FT		LB	LB	LB	LB					
							SHEET SUBTOTALS	SF 58.00	SF	EA ~~3~~ 2				EA ~~3~~ 2		EA 10	FT 150		EA	LB								

FINAL POST LENGTHS ARE TO BE DETERMINED IN THE FIELD. POST SIZES ARE COMPUTED BASED ON INFORMATION FURNISHED ON THE STANDARD SHEETS AND THE VTRANS "SIGN POST DESIGN GUIDE".

PROJECT NAME: STATEWIDE NORTHEAST REGION
PROJECT NUMBER: STP HRRR(8)

FILE NAME: d10k316_wrk.dgn
PROJECT LEADER: JLS
DESIGNED BY: NLA
BARTON TRAFFIC SIGN SUMMARY 6

PLOT DATE: 09-AUG-2011
DRAWN BY: ITS
CHECKED BY: JLS
SHEET 14 OF 28