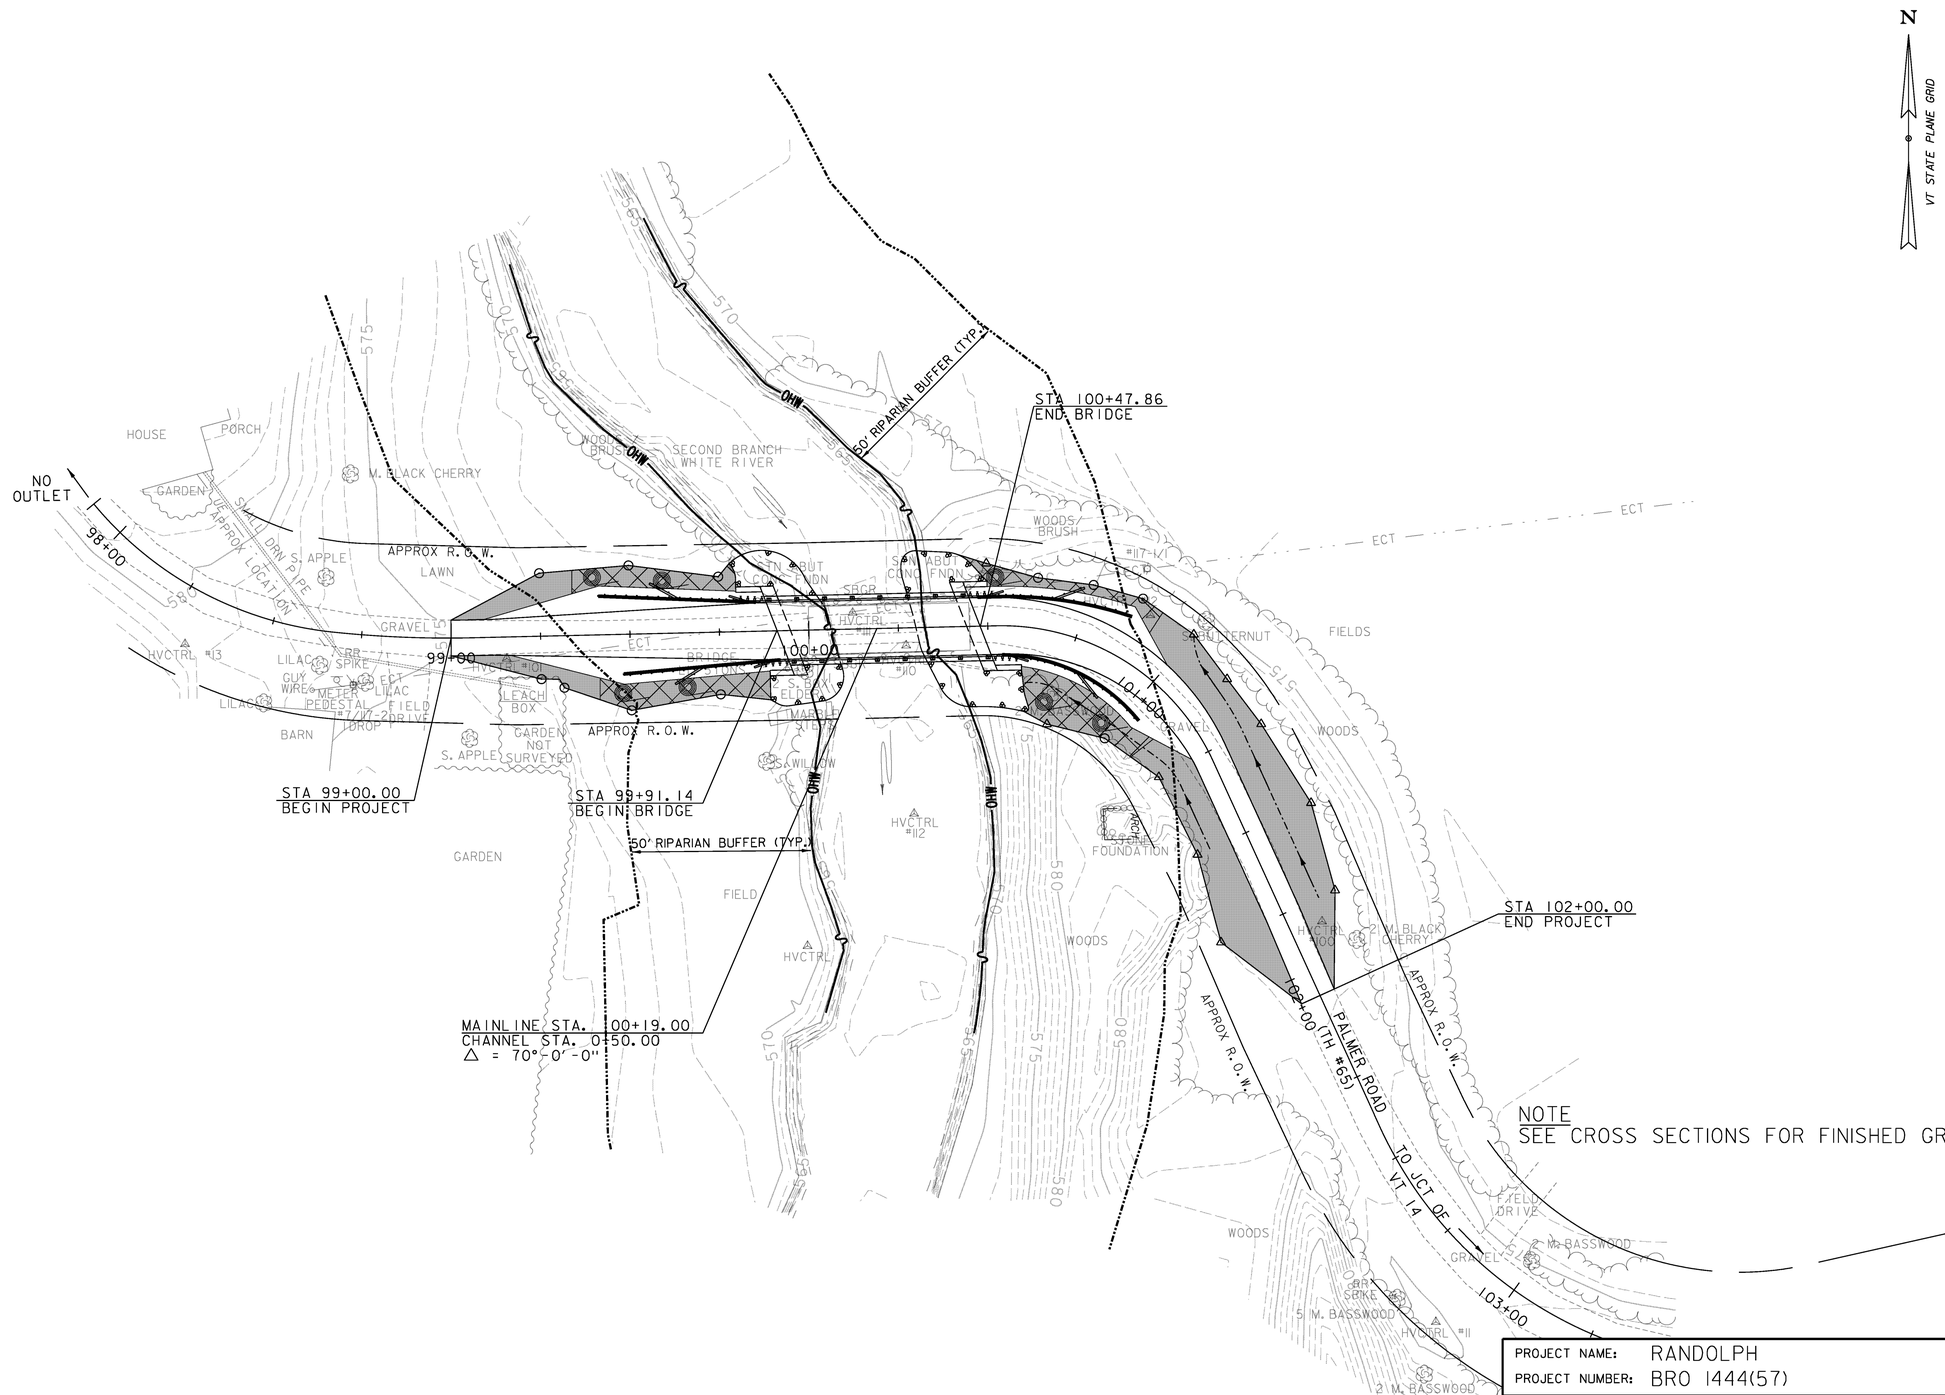

NOTE
SEE CROSS SECTIONS FOR FINISHED GRADING

PROJECT NAME:	RANDOLPH
PROJECT NUMBER:	BRO 1444(57)

FILE NAME: z11j078bdrerofl.dgn	PLOT DATE: 8/12/2014
PROJECT LEADER: J. BYATT	DRAWN BY: S. GOODWIN
DESIGNED BY: J. SMITH	CHECKED BY: D. MUNRO
EPSC FINAL PLAN SHEET	SHEET 36 OF 39

CLD 12-0175 MODEL: 01