ATHENS

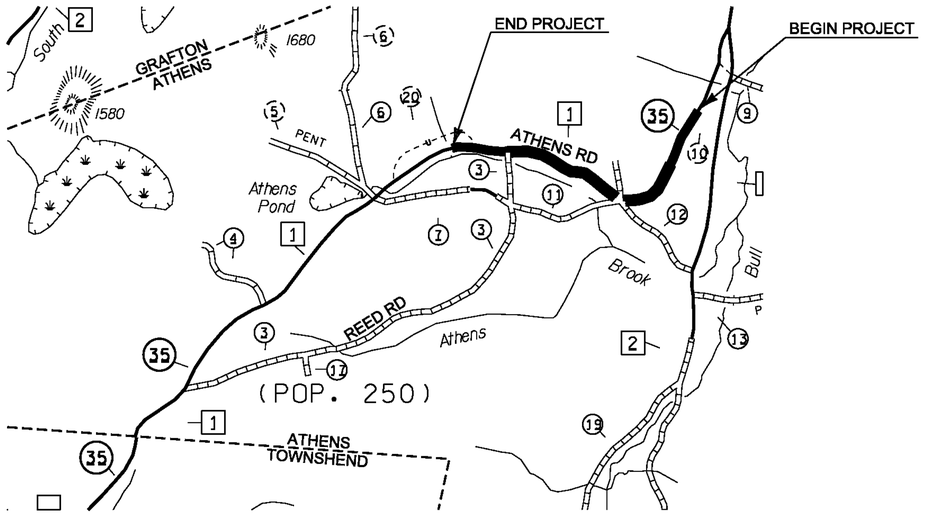

WORK TO BEGIN AT A POINT 0.525 MILES EAST OF MILL ROAD (TH-12) ALONG STATE NUMBERED TOWN HIGHWAY 35 (TH-1) IN THE TOWN OF ATHENS, DESIGNATING THIS POINT AS MILE MARKER 0.00 AND EXTENDING WESTERLY ALONG STATE NUMBERED TOWN HIGHWAY 35 (TH-1) FOR A DISTANCE OF 1.389 MILES TO A POINT 0.245 MILES WEST OF THE MOST EASTERLY INTERSECTION REED ROAD (TH-3) ALONG STATE NUMBERED TOWN HIGHWAY 35 (TH-1) TO CONCLUDE THIS SEGMENT OF THIS PROJECT.

BETHEL

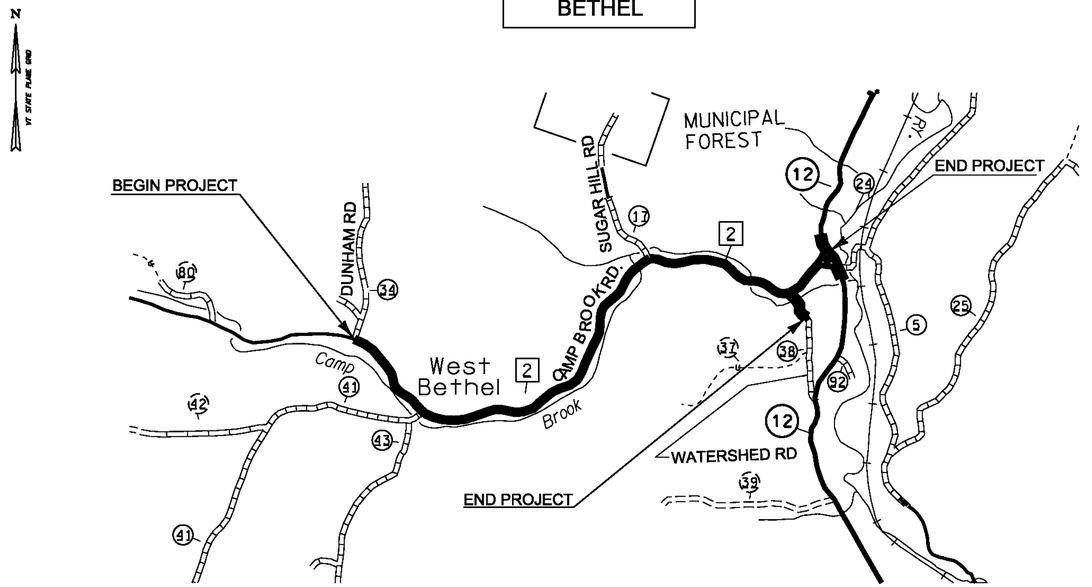

WORK TO BEGIN AT 0.48 MILES WEST OF MILE MARKER 2.80 ON CAMP BROOK ROAD (TH-2) IN THE TOWN OF BETHEL, DESIGNATING WHERE POLE # 79/54/73 AS BEING LOCATED AT MILE MARKER 3.00 WHICH IS 634 FEET EAST OF DUNHAM ROAD. WORK TO CONTINUE ALONG CAMP BROOK ROAD FOR A DIASTANCE OF 3.10 MILES TO THE INTERSECTION OF VT ROUTE 12 (MM 6.10) TO CONCLUDE THIS SEGMENT OF THIS PROJECT.

ALSO WORK TO BEGIN AT MILE MARKER 3.80 ALONG VT ROUTE 12 IN THE TOWN OF BETHEL AND EXTEND 0.311 MILES NORTH TO A POINT 333 FEET SOUTH OF POLE # 64-A (MM 4.111) TO CONCLUDE THIS SEGMENT OF THIS PROJECT.

BEGINNING AT THE INTERSECTION OF CAMP BROOK ROAD (TH-2) AND WATERSHED ROAD (TH-38) IN THE TOWN OF BETHEL, DESIGNATING WHERE THE CENTERLINE OF EACH OF THESE ROADS INTERSECTS EACH OTHER AS MILE MARKER 0.00 AND EXTENDING SOUTHERLY 0.157 MILES TO A POINT 63 FEET SOUTH OF POLE # 56 ALONG WATERSHED ROAD (TH-38) TO CONCLUDE THIS SEGMENT OF THIS PROJECT

GRAFTON

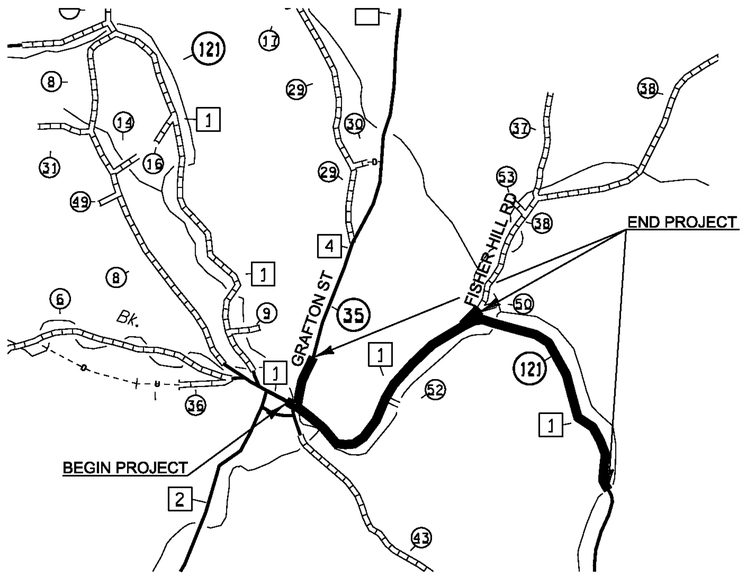

WORK TO BEGIN AT A POINT 0.020 MILES WEST OF THE INTERSECTION OF STATE NUMBERED TOWN HIGHWAY 35 / GRAFTON STREET (TH-4) AND STATE NUMBERED HIGHWAY 121 (TH-1) IN THE TOWN OF GRAFTON, DESIGNATING THIS POINT AS MILE MARKER 0.00 AND EXTENDING SOUTHERLY ALONG STATE NUMBERED TOWN HIGHWAY 121 FOR A DISTANCE OF 2.373 MILES TO A POINT 48 FEET NORTH OF POLE # 3/401/VTEL/64-1 TO CONCLUDE THIS SEGMENT.

ALSO, BEGINNING AT THE INTERSECTION OF STATE NUMBERED TOWN HIGHWAY 121 (TH-1) AND FISHER HILL ROAD (TH-38) IN THE TOWN OF GRAFTON, DESIGNATING WHERE THE CENTERLINE OF EACH OF THESE ROADS INTERSECTS EACH OTHER AS MILE MARKER 0.00 AND EXTENDING NORTHEASTERLY ALONG FISHER HILL ROAD (TH-38) FOR A DISTANCE OF 0.061 MILES TO A POINT 50 FEET NORTH OF POLE # 353/NTEL/1 TO CONCLUDE THIS SEGMENT.

ON ANOTHER ROAD, BEGINNING AT THE INTERSECTION OF STATE NUMBERED TOWN HIGHWAY 35 / GRAFTON STREET (TH-4) AND STATE NUMBERED TOWN HIGHWAY 121 (TH-1) IN THE TOWN OF GRAFTON, DESIGNATING THIS POINT AS MILE MARKER 0.00 AND EXTENDING NORTHERLY 0.207 MILES ALONG STATE NUMBERED TOWN HIGHWAY 35 / GRAFTON STREET (TH-4) TO A POINT 95 FEET NORTH OF POLE # 346/5/VTEL/11/5 TO CONCLUDE THIS SEGMENT OF THIS PROJECT.

RANDOLPH

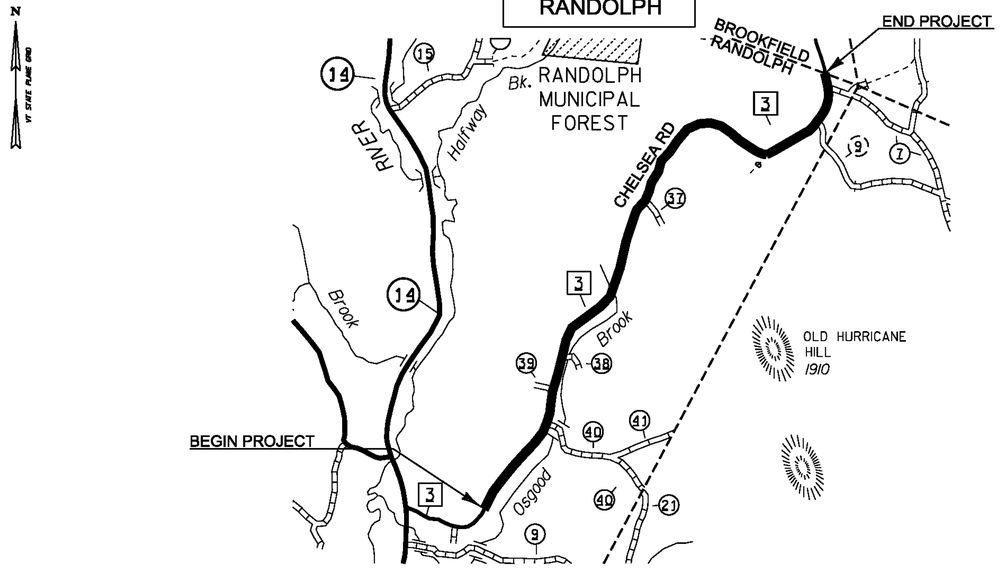

BEGINNING AT THE INTERSECTION OF VT ROUTE 14 AND CHELSEA ROAD (TH-3) IN THE TOWN OF RANDOLPH, DESIGNATING WHERE THE CENTERLINE OF EACH OF THESE ROADS INTERSECTS EACH OTHER AS MILE MARKER 0.00 AND EXTENDING NORTHERLY ALONG CHELSEA ROAD (TH-3) FOR A DISTANCE OF 1.375 MILES TO THE POINT WHERE THE WORK IS TO BEGIN, THEN FROM THIS POINT EXTENDING 2.130 MILES TO THE RANDOLPH-BROOKFIELD TOWNLINE (MM 3.513) TO CONCLUDE THIS SEGMENT OF THIS PROJECT.

NOT TO SCALE

PROJECT NAME:	STATEWIDE SOUTHEAST REGION
PROJECT NUMBER:	STP HRRR(14)
FILE NAME:	12k022wrk.dgn
PROJECT LEADER:	JLS
DESIGNED BY:	NLA
LOCATION MAPS SHEET 1	
PLOT DATE:	23-JUL-2012
DRAWN BY:	TDS
CHECKED BY:	NLA
SHEET	9 **OF** 65