STATE OF VERMONT
AGENCY OF TRANSPORTATION

TRAFFIC SIGN SUMMARY SHEET 5

BETHEL

DIRECTION	MILEMARKER, STATION, OR SIGN NUMBER	LOCATION	MANUAL ON UNIFORM TRAFFIC DEVICES OR STATE CODE	SIGN DIMENSIONS WIDTH	SIGN DIMENSIONS HEIGHT	SHEETING REMARKS	SIGN LEGEND	NEW SIGNS "A"	NEW SIGNS "B"	EXISTING SIGNS RETAIN	EXISTING SIGNS SALVAGE FROM	EXISTING SIGNS SALVAGE TO	EXISTING SIGNS REMOVE	EXISTING POST RETAIN	EXISTING POST REMOVE	NO. OF NEW POSTS	SQUARE STEEL (In) 1.75 lb/ft 1.88	SQUARE STEEL (In) 2.00 lb/ft 2.42	SQUARE STEEL (In) 2.50 lb/ft 3.35	TUBULAR STEEL O/(In) FOUNDATION	TUBULAR STEEL O/(In) 3.00 lb/ft 7.60	TUBULAR STEEL O/(In) 3.50 lb/ft 9.00	TUBULAR STEEL O/(In) 4.00 lb/ft 10.80	TUBULAR STEEL O/(In) 5.00 lb/ft 14.60	SIGN FRAME REQUIRED	REMARKS (SHSM = STANDARD HIGHWAY SIGN & MARKING BOOK)	SIGN DETAIL: DETAIL IN SHSM	SIGN DETAIL: DETAIL ON SHEET NUMBER	SIGN DETAIL: STANDARD SHEET NUMBER
EB	MM 4.717, RT.	A	W1-4L	30	30			6.25								1.00		15								INSTALL NEW SIGN AND POST. LOCATED 700' EAST OF POLE # 31-1 / 26-1.	X		
		A	W13-1	18	18			2.25																		INSTALL NEW SIGN BELOW THE W1-4 SIGN LOCATED EAST OF POLE # 31-1 / 26-1.	X		
EB	MM 4.740, RT. TO MM 4.780, RT.	AB		6	8		(6) TYPE II - 6" x 8" WHITE DELINEATORS																			INSTALL NEW DELINEATORS (6) BACK-TO-BACK 55' APART ON 3 POSTS, INSTALL FIRST POST 580' EAST OF POLE # 31-1 / 26-1.		5	
WB	4.784 MM ~~4.850~~, LT.	F	W1-2R	30	30			6.25					MISSING ~~X~~		~~X~~	1.00		15								REPLACE EXISTING SIGN AND POST. LOCATED ~~ADJACENT~~ 350' WEST OF TO POLE # 7p~~51~~ 31 / 26.	X		
		F	W13-1	18	18			2.25					MISSING ~~X~~													REPLACE EXISTING SIGN BELOW THE W1-4 SIGN LOCATED ADJACENT TO POLE # 7p~~51~~ 31 / 26.	X		
EB	MM 5.060, RT.	A	W1-4R	30	30								X		X											REMOVE EXISTING SIGN AND POST LOCATED 150' EAST AND ACROSS FROM POLE # 24 / 19.			
		A	W13-1	18	18								X													REMOVE EXISTING SIGN BELOW THE W1-4 SIGN LOCATED 150' EAST AND ACROSS FROM POLE # 24 / 19.			
EB	MM 5.080, RT.	A	W1-4R	30	30			6.25								1.00		15								60' INSTALL NEW SIGN AND POST. LOCATE IT ~~45'~~ EAST AND ACROSS FROM POLE # 24 / 19.	x		
		A	W13-1	18	18			2.25																		60' INSTALL NEW SIGN BELOW THE W1-4 SIGN LOCATED ~~45'~~ EAST AND ACROSS FROM POLE # 24 / 19.	X		
WB	MM 5.120, LT.	E F	W1-8R W1-8L	18 18	24 24		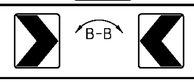	3.00 3.00								1.00		15								INSTALL TWO CHEVRONS ON ONE POST USING A BRACKET. LOCATE IT 170' WEST OF POLE # 24 / 19.	X		
WB	MM 5.135, LT.	E F	W1-8R W1-8L	18 18	24 24		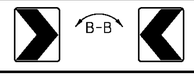	3.00 3.00								1.00		15								INSTALL TWO CHEVRONS ON ONE POST USING A BRACKET. LOCATE IT 248' WEST OF POLE # 24 / 19.	X		
								SF 37.50	SF	EA 4			EA 4 ~~4~~ 2	EA 2	EA 2	EA 5	FT 75	FT 75	FT	EA	LB	LB	LB	LB					

FINAL POST LENGTHS ARE TO BE DETERMINED IN THE FIELD. POST SIZES ARE COMPUTED BASED ON INFORMATION FURNISHED ON THE STANDARD SHEETS AND THE VTRANS "SIGN POST DESIGN GUIDE".

PROJECT NAME: STATEWIDE SOUTHEAST REGION
PROJECT NUMBER: STP HRRR(14)

FILE NAME: 12k022wrk.dgn
PROJECT LEADER: JLS
DESIGNED BY: NLA
BETHEL TRAFFIC SIGN SUMMARY SHEET 5

PLOT DATE: 23-JUL-2012
DRAWN BY: TDS
CHECKED BY: NLA
SHEET 25 OF 65