STATE OF VERMONT
AGENCY OF TRANSPORTATION

TRAFFIC SIGN SUMMARY SHEET 3

SPRINGFIELD

DIRECTION	MILEMARKER, STATION, OR SIGN NUMBER	LOCATION	MANUAL ON UNIFORM TRAFFIC DEVICES OR STATE CODE	SIGN DIMENSIONS WIDTH	SIGN DIMENSIONS HEIGHT	SHEETING REMARKS	SIGN LEGEND	NEW SIGNS "A"	NEW SIGNS "B"	EXISTING SIGNS RETAIN	EXISTING SIGNS SALVAGE FROM	EXISTING SIGNS SALVAGE TO	EXISTING SIGNS REMOVE	EXISTING POST RETAIN	EXISTING POST REMOVE	NO. OF NEW POSTS	SQUARE STEEL (in) 1.75 lb/ft 1.88	SQUARE STEEL (in) 2.00 lb/ft 2.42	SQUARE STEEL (in) 2.50 lb/ft 3.35	TUBULAR STEEL O/(in) FOUNDATION	TUBULAR STEEL O/(in) 3.00 lb/ft 7.60	TUBULAR STEEL O/(in) 3.50 lb/ft 9.00	TUBULAR STEEL O/(in) 4.00 lb/ft 10.80	TUBULAR STEEL O/(in) 5.00 lb/ft 14.60	SIGN FRAME REQUIRED	REMARKS SHSM = STANDARD HIGHWAY SIGN & MARKING BOOK	SIGN DETAIL DETAIL IN SHSM	SIGN DETAIL DETAIL ON SHEET NUMBER	SIGN DETAIL STANDARD SHEET NUMBER
							SPOONERVILLE RD																						
EB	MM 0.110, RT.	A	W1-10cL	36	36			9.00								2.00		30								INSTALL A NEW W1-10c L SIGN AND POSTS ACROSS FROM POLE # 402 / 2 / 21.	X		
		A	W16-8P	42	8			2.33																		INSTALL A NEW W16-8P SIGN BELOW THE W1-2Mh L SIGN LOCATED ACROSS FROM POLE # 402 / 2 / 21.		12	
WB	MM 0.209, LT.	F	W1-10bR	36	36		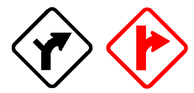	9.00 9.00							1	2.00		30		ORIGINAL SIGN WAS INSTALLED BECAUSE OF COMPLAINTS FROM DRIVERS. SIGN WAS PAID TWICE.						INSTALL A NEW W1-10b R SIGN AND POSTS 217' WEST OF POLE # 16.	X		
		F	W16-8P	42	8			2.33																				12	
							BELLOWS RD																						
EB	MM 0.077, RT.	F	W3-1	30	30			6.25								1.00		15								INSTALL A NEW W3-1 SIGN AND POST. LOCATE IT 220' EAST OF POLE # 6S / 6-1.	X		
								4.50																					
								9.00																				
								SF ~~28.91~~ 51.41	SF	EA	EA	EA	EA	EA 1	EA	EA 5	FT 75	FT 75	FT	EA	LB	LB	LB	LB					

FINAL POST LENGTHS ARE TO BE DETERMINED IN THE FIELD. POST SIZES ARE COMPUTED BASED ON INFORMATION FURNISHED ON THE STANDARD SHEETS AND THE VTRANS "SIGN POST DESIGN GUIDE".

PROJECT NAME: STATEWIDE SOUTHEAST REGION
PROJECT NUMBER: STP HRRR(14)

FILE NAME: 12k022wrk.dgn
PROJECT LEADER: JLS
DESIGNED BY: NLA
SPRINGFIELD TRAFFIC SIGN SUMMARY SHEET 3

PLOT DATE: 23-JUL-2012
DRAWN BY: TDS
CHECKED BY: NLA
SHEET 51 OF 65