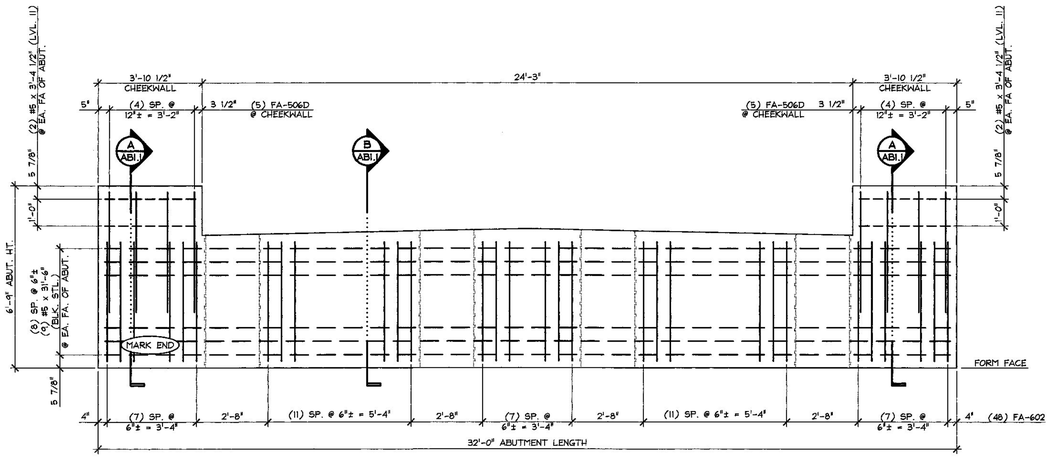

1 / AB1.1 REINFORCING ELEVATION VIEW IN FORM

3/8" = 1'-0"

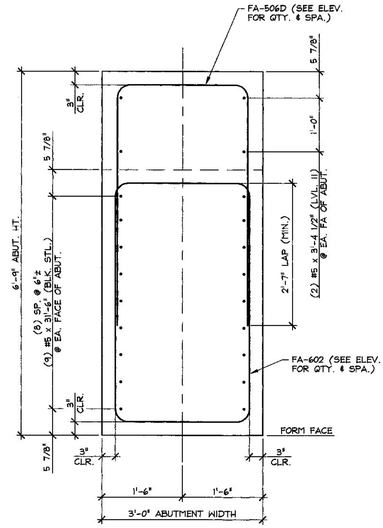

A / AB1.1 ABUTMENT SECTION

3/4" = 1'-0"

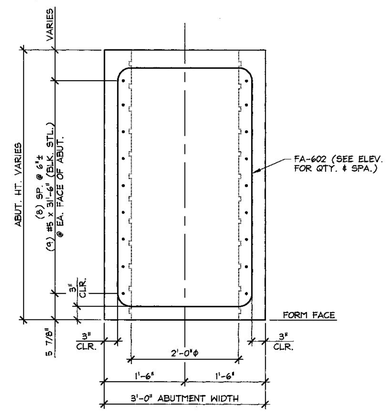

B / AB1.1 ABUTMENT SECTION

3/4" = 1'-0"

MARK: FA-AB1	QTY.: 1
MARK: FA-AB2	QTY.: 1

MATERIAL LIST / ABUTMENT

ITEM	MARK	DESCRIPTION	QTY.
1		#5 x 31'-6" (LEVEL I, BLACK STEEL)	18
2		#5 x 31'-4 1/2" (LEVEL II, DUAL COATED)	8
3			
4	FA-506D	#5 BENT BAR (LEVEL II, DUAL COATED)	10
5			
6	FA-602	#6 BENT BAR (LEVEL I, BLACK STEEL)	48
7			
8			
9			
10			

Vermont Agency of Transportation

RECEIVED

CK'D BY RK/JW OK'D BY RY

February 12, 2015

RESUBMIT No Approved

BY RY DATE 02/12/2015

⚠ 2-10-15 REVISED PER VT AOT COMMENTS

APPROVAL STAMP:

J.P. CARRARA & SONS INC.
Precast & Prestress Manufacturer
2464 CASE STR., MIDDLEBURY, VERMONT 05753 Phone:(802)388-6361 Fax:(802)388-9010

A.L. St. ONGE
CONTRACTOR
MONTOMERY, VERMONT

STATE OF VERMONT AGENCY OF TRANSPORTATION
COUNTY OF FRANKLIN

DATE: NOV. 10, 2014
SCALE: NOTED

TOWN OF FAIRFIELD
SOUTH ROAD, FAS 0281 (RURAL MAJOR COLLECTOR)
BRIDGE NO.: 14 PROJECT NO.: BRF 0281(25)

CHKD: B.C. DFTM: B.L.
JOB NO: 23446-014

PRECAST ABUTMENT REINFORCING DETAILS

DWG. NO: AB1.1

F:\VT-Bridges\23446-14 Fairfield\South Road\23446-AB1-1.dwg, 2/11/2015 1:00:50 PM