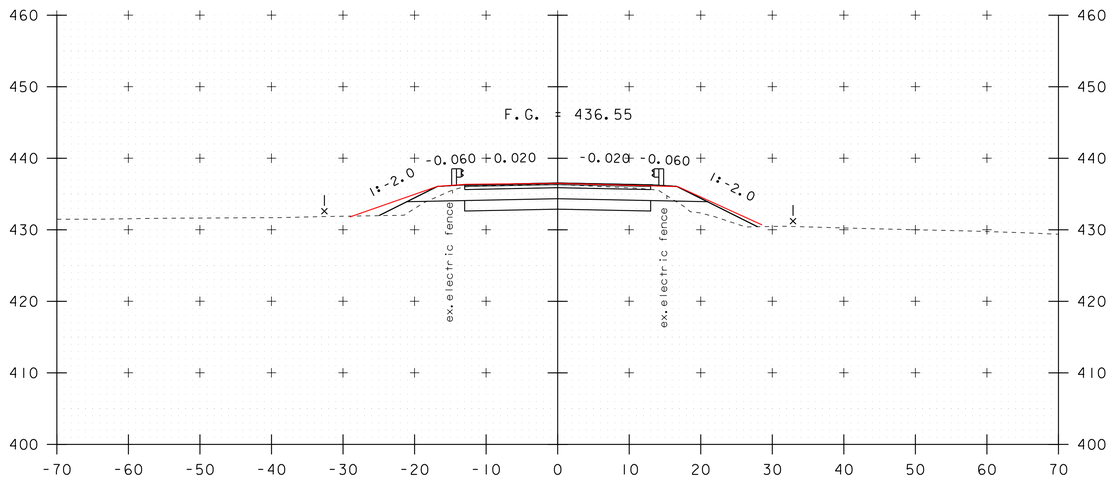

43+75

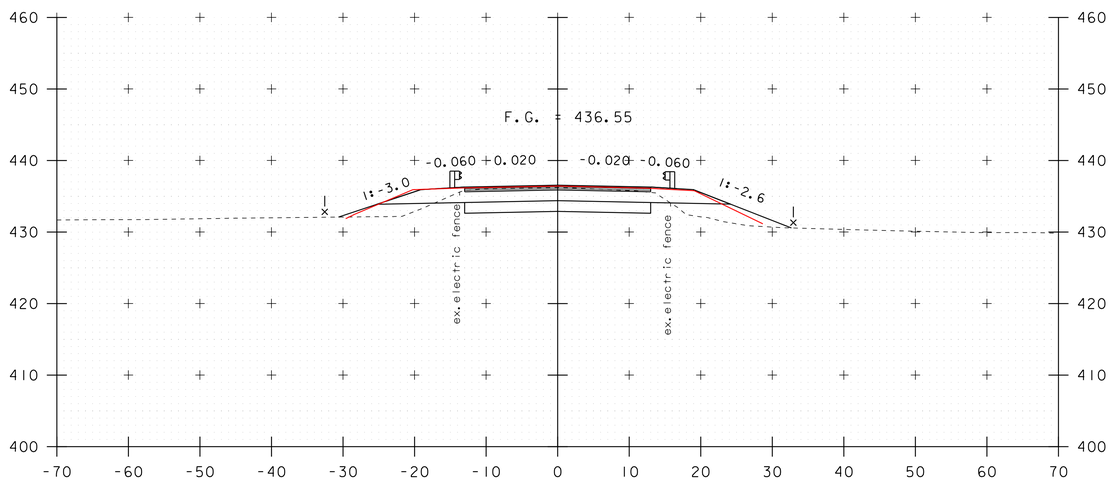

43+50
BEGIN PROJECT

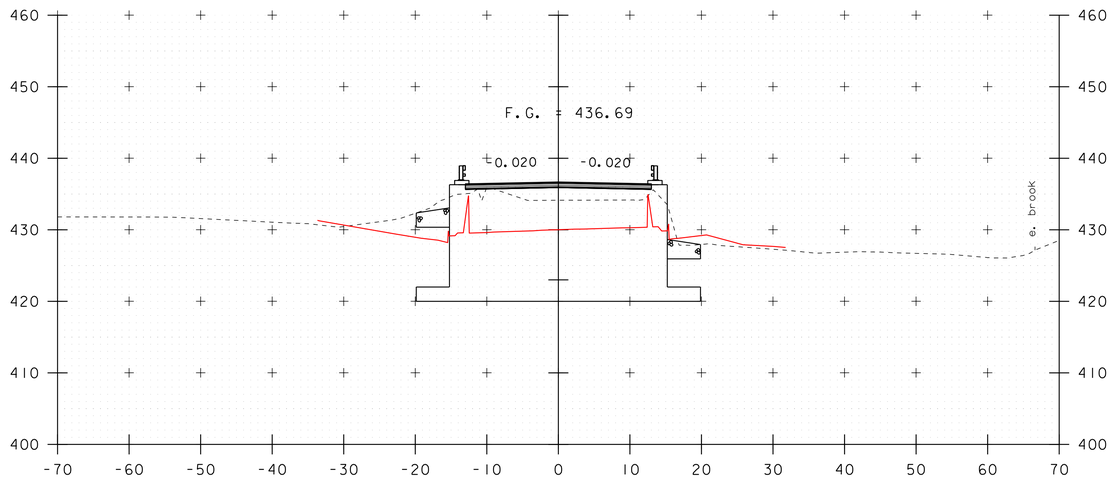

44+25
STA 44+24 BEGIN BRIDGE

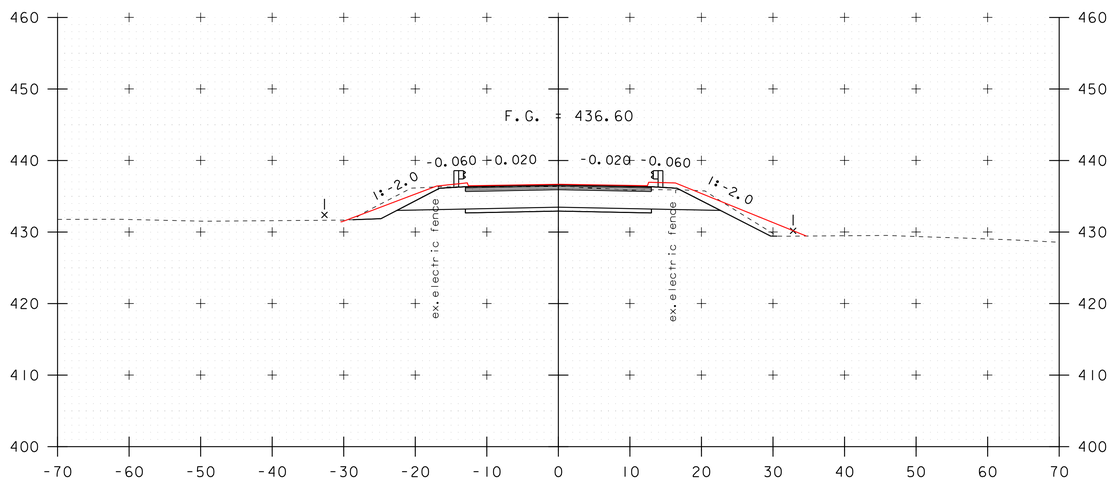

44+00

STA. 43+50 TO STA. 44+25

PROJECT NAME: RICHFORD
PROJECT NUMBER: BRF 0302(29)

FILE NAME: sl2j158xs.dgn
PROJECT LEADER: C. CARLSON
DESIGNED BY: H. SALLS
MAINLINE CROSS SECTIONS 2

PLOT DATE: 09-AUG-2016 09:57
DRAWN BY: R. PELLETT
CHECKED BY: H. SALLS
SHEET 25 OF 64