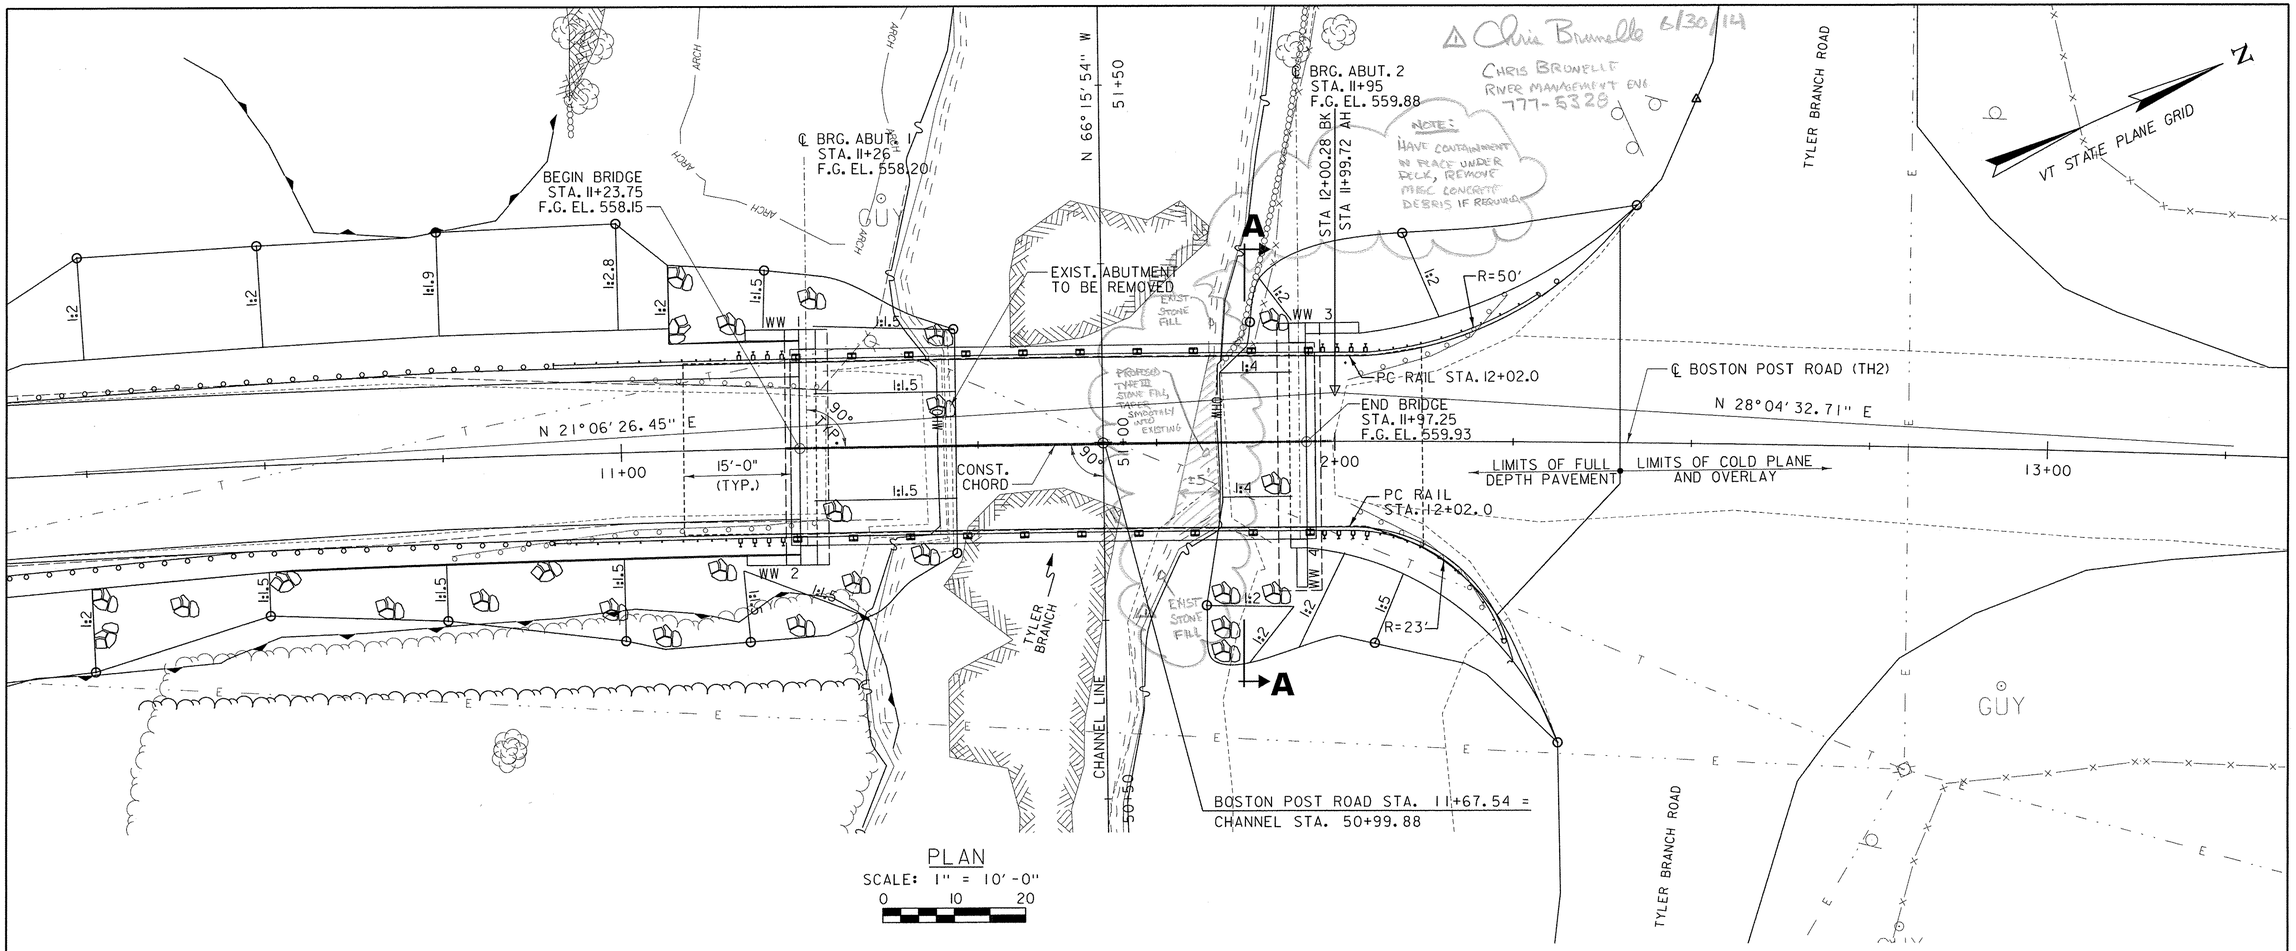

PLAN

SCALE: 1" = 10'-0"

0 10 20

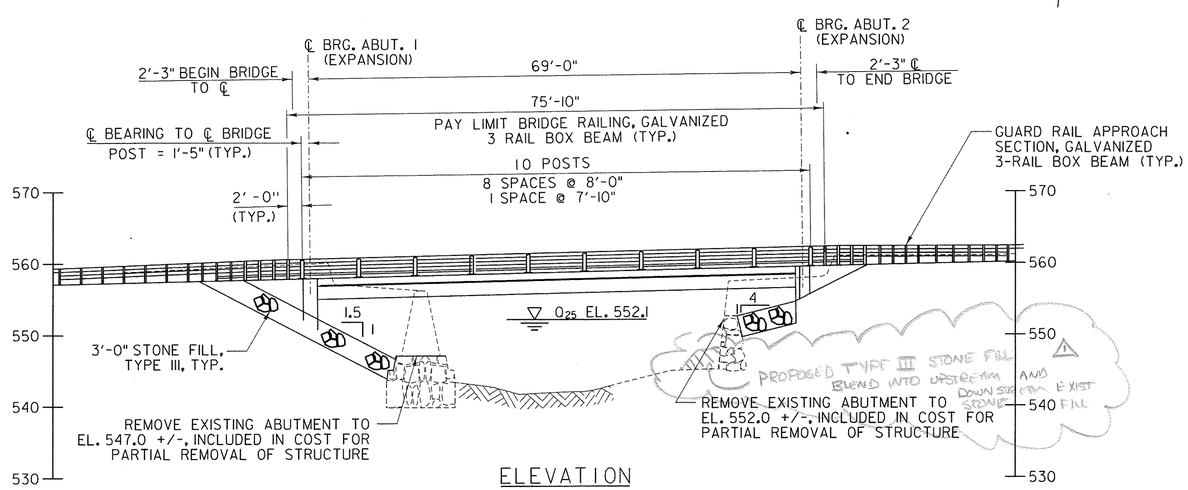

ELEVATION

SCALE: 1" = 10'-0"

0 10 20

NOTE:
FOR APPROXIMATE LIMITS OF REMOVAL OF EXISTING WALL AT ABUTMENT 2, REFER TO VIEW A-A ON SHEET 29.

Stantec

PROJECT NAME: ENOSBURG	
PROJECT NUMBER: BRO 1448(40)	
FILE NAME: ...\Plot Files\xx Plan_Elev.dgn	PLOT DATE: 10/4/2013
PROJECT LEADER: G. BOGUE	DRAWN BY: E. ALLING
DESIGNED BY: G. GOYETTE	CHECKED BY: G. GOYETTE
PLAN AND ELEVATION SHEET	SHEET 20 OF 46