Enosburg BRO 1448 (40)
Structure Excavation, Granular Backfill
Abutment 2
Drawn By: Alan Therrien
Checked By: Jon Day

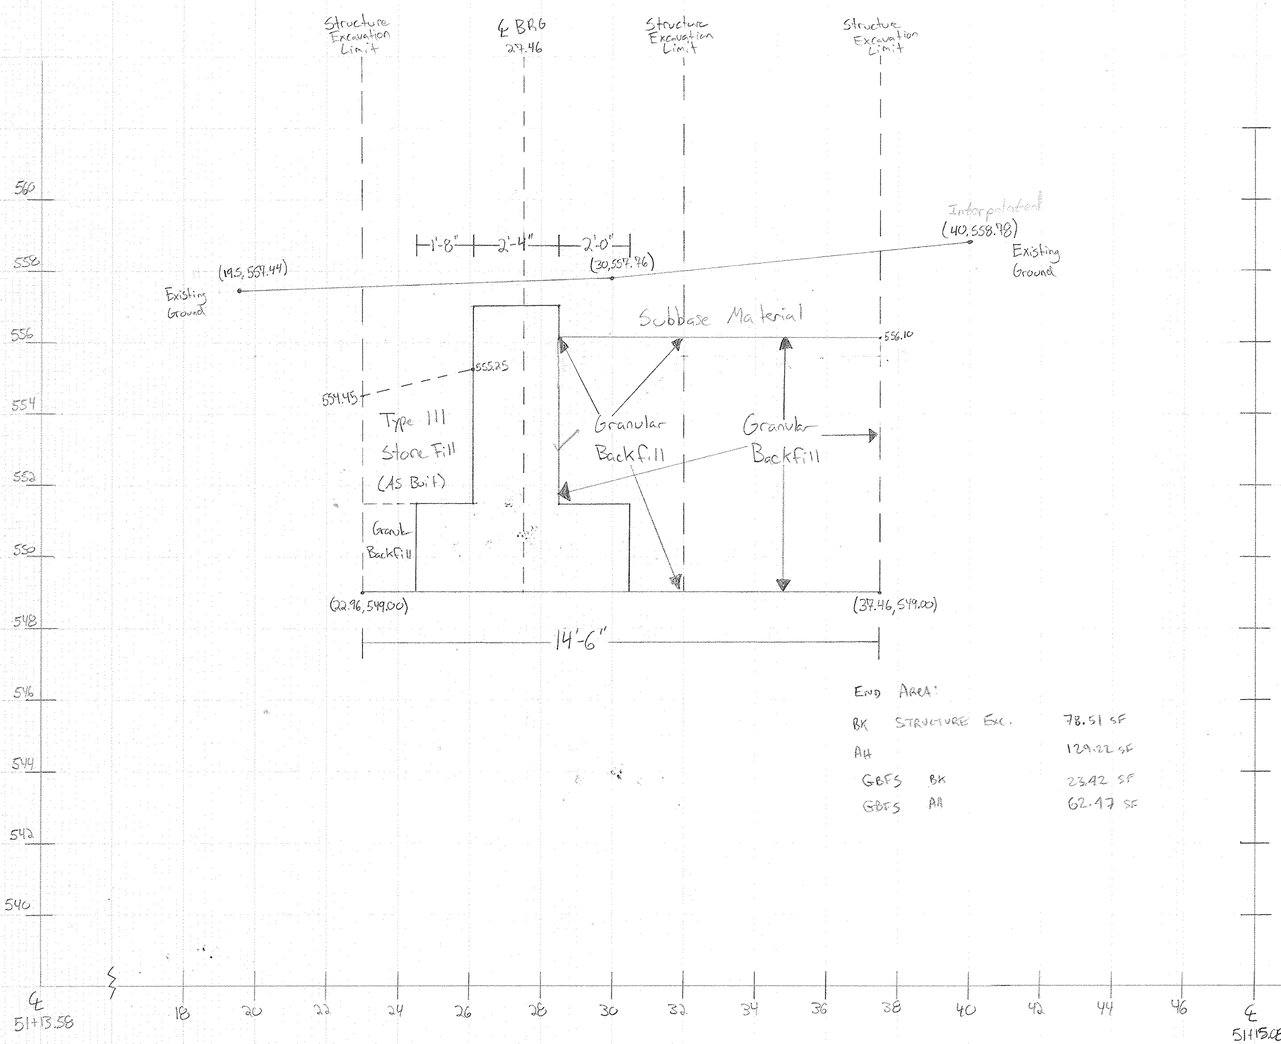

END AREA:

BK	STRUCTURE EXC.	78.51 SF
AH		129.22 SF
GBFS	BK	23.42 SF
GBFS	AH	62.47 SF

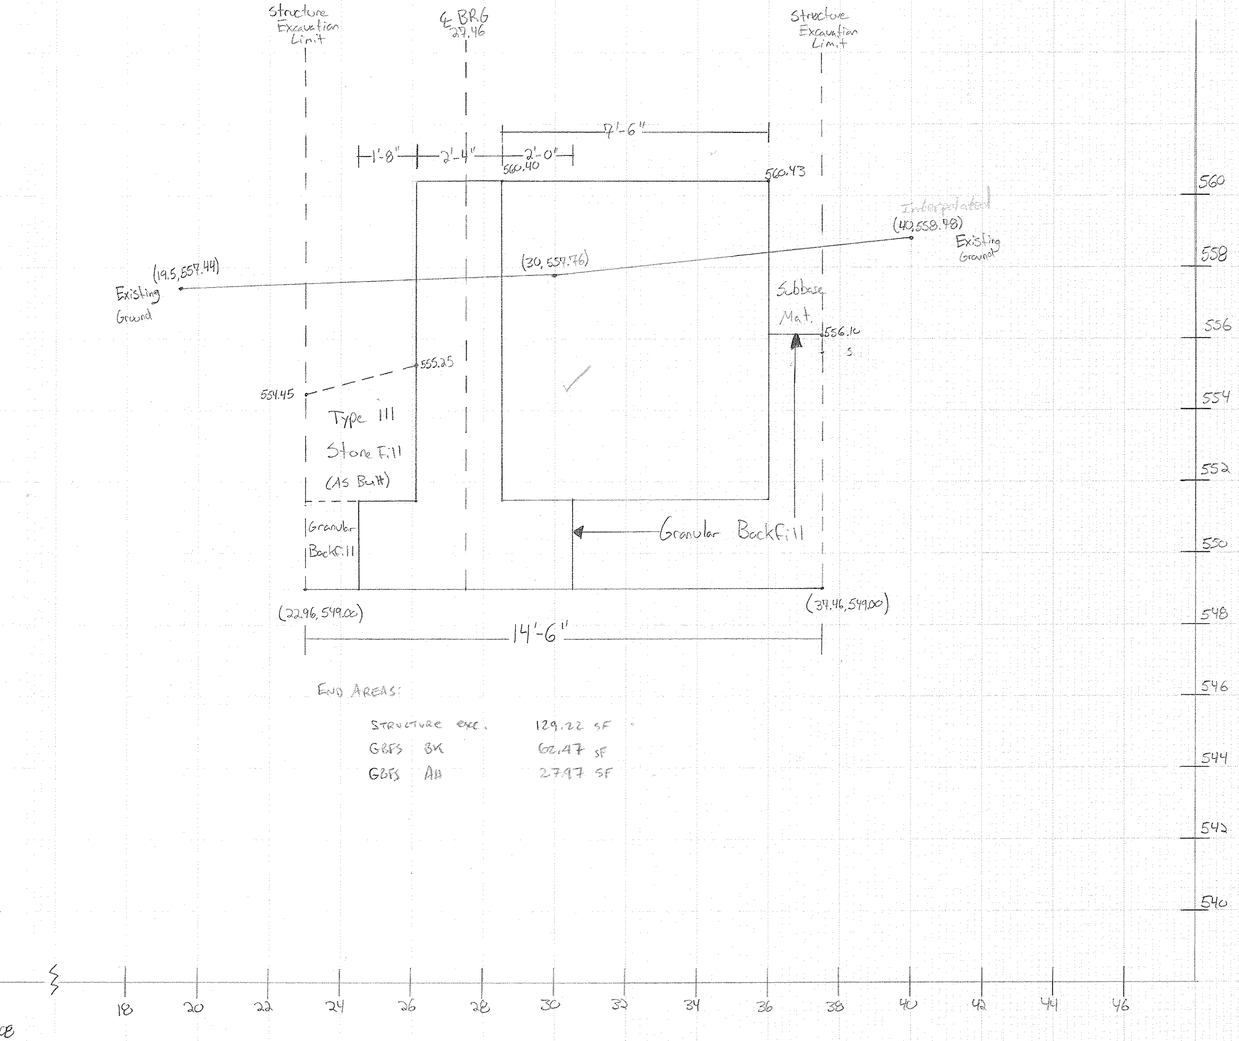

END AREAS:

STRUCTURE EXC.		129.22 SF
GBFS	BK	62.47 SF
GBFS	AH	27.47 SF

✓ JPD 08-19-14