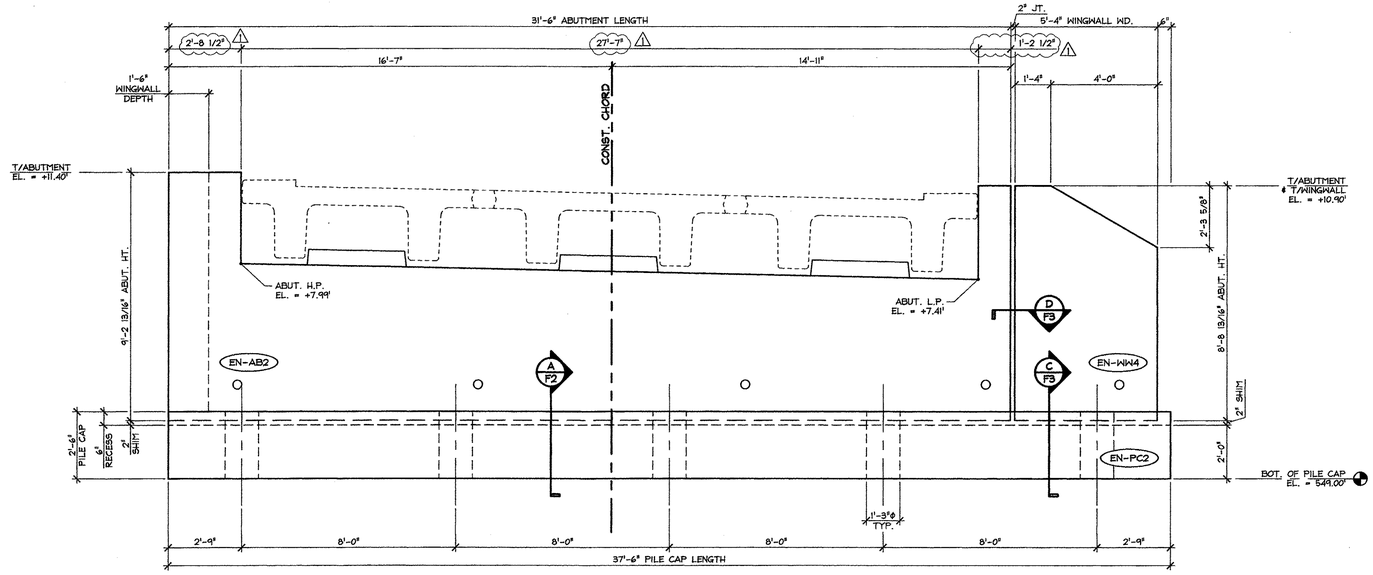

1 / F3 ABUTMENT #2 ELEVATION
3/8" = 1'-0"

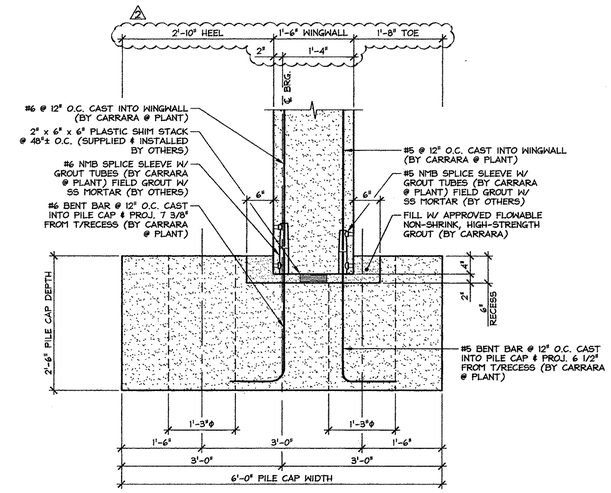

C / F3 WINGWALL CONNECTION DETAIL
3/4" = 1'-0"

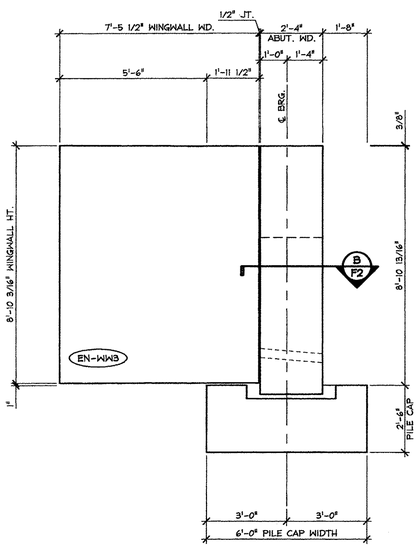

2 / F3 WINGWALL #3 ELEVATION
3/8" = 1'-0"

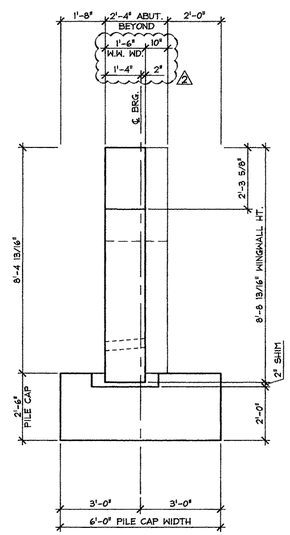

3 / F3 WINGWALL #4 ELEVATION
3/8" = 1'-0"

APPROVED: Approval of drawings and/or procedures indicates concurrence with the information presented and does not relieve the Contractor or Fabricator of compliance with all specifications and code requirements	✓	Stantec
APPROVED AS NOTED		
REVISE AND RESUBMIT		
NOT REVIEWED		
Date: 4-29-2014		
By: Jonar Hyffnel		

This review by Stantec Consulting Services Inc. is for the sole purpose of ascertaining conformance with the general design concept. This review shall not mean that Stantec Consulting Services Inc approves the detail design inherent in the shop drawings, responsibility for which shall remain with the Contractor. Submitting same, and such review shall not relieve the Contractor of his responsibility for errors or omissions in the shop drawing or of his responsibility for meeting all requirements of the Contract Documents. The contractor is responsible for dimensions to be confirmed and correlated at the job site, for information that pertains solely to the fabrication processes or to techniques of construction and installation and for coordination of the work of all subtrades.

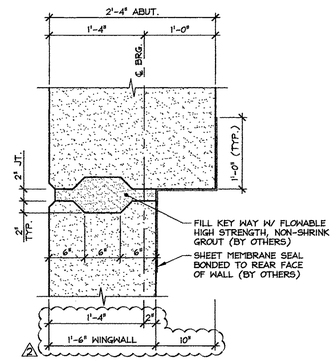

D / F3 ABUTMENT / WING WALL SHEAR KEY DETAIL
1" = 1'-0"

Vermont Agency of Transportation
RECEIVED
ON: April 28, 2014
and Checked for
CONFORMANCE
BY: Rob Young DATE: 05/01/2014

SUBMITTED
APR 28 2014
J. P. CARRARA & SONS, INC.
MIDDLEBURY, VT 05753

△2 4-28-14 REVISED AS NOTED
△1 4-7-14 REVISED AS NOTED

APPROVAL STAMP:

J.P. CARRARA & SONS INC.
Precast & Prestress Manufacturer
2464 CASE STR., MIDDLEBURY, VERMONT 05753 Phone:(802)388-6361 Fax:(802)388-9010

A.L. St. ONGE CONTRACTOR, INC.
CONTRACTOR
MONTGOMERY CENTER, VERMONT

STATE OF VERMONT AGENCY OF TRANSPORTATION
COUNTY OF FRANKLIN

TOWN OF ENOSBURG
BOSTON POST ROAD T.H.2 CLASS 2
BRIDGE NO.: 48 PROJECT NO.: BRO 1448(40)

ABUTMENT #2 ELEVATIONS

DATE: APR. 24, 2014
SCALE: NOTED
CHKD: M.W. DFTM: B.L.
JOB NO: 23418-013
DWG. NO: F3

F:\VT-Bridges\23418-13 Enosburg\23418-F3-A.dwg, 4/28/2014 10:55:41 AM