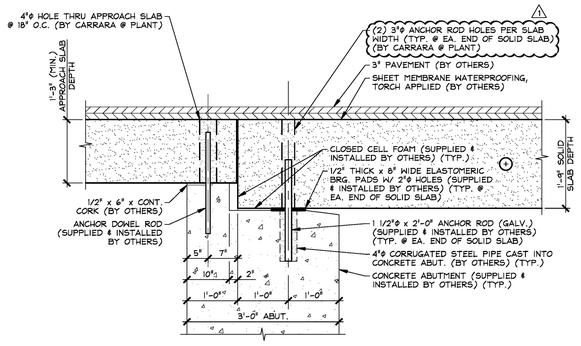

A / F3 BEARING SECTION
3/4" = 1'-0"

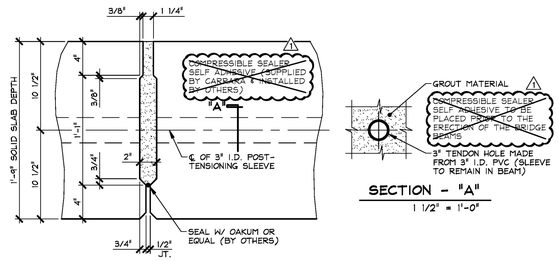

SECTION - "A"
1 1/2" = 1'-0"

B / F3 SHEAR KEY SECTION @ P.T. SLEEVE
1 1/2" = 1'-0"

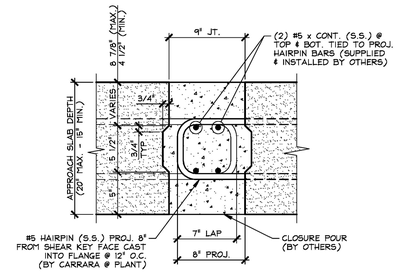

C / F3 SHEAR KEY SECTION @ APPROACH SLABS
1 1/2" = 1'-0"

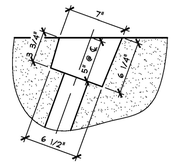

PLAN OF POCKET

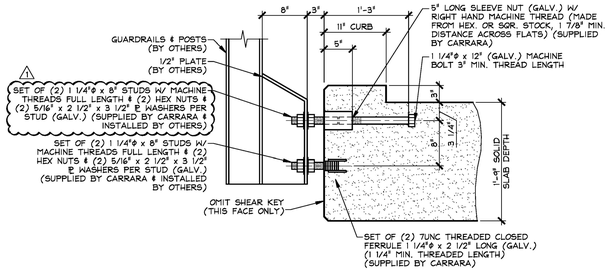

D / F3 GUARDRAIL ANCHORAGE SECTION
1" = 1'-0"

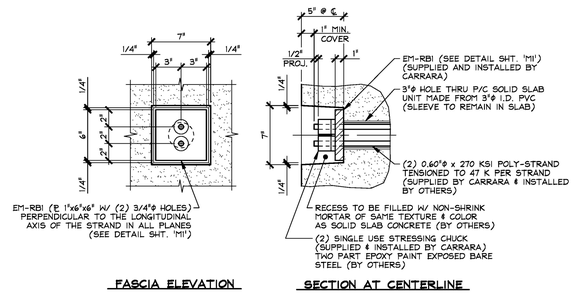

FASCIA ELEVATION — SECTION AT CENTERLINE

D E T A I L - "A"
1 1/2" = 1'-0"

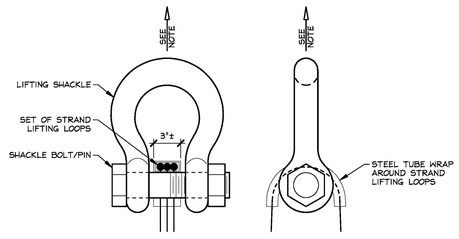

NOTE: SOLID SLAB SHALL BE HANDLED AND ERECTED USING THE LIFTING LOOPS ONLY. RIGGING SHALL BE CONFIGURED SUCH THAT EQUAL FORCES ARE APPLIED TO EACH SET OF LIFTING LOOPS AT EACH END OF THE SLAB. SHACKLE BOLT/PIN SHALL BE PLACED UNDER LIFT LOOPS AS SHOWN. DESIGN AND CONFIGURATION OF RIGGING BY PURCHASER.

LIFTING SHACKLE DETAILS
N.T.S.

Vermont Agency of Transportation
RECEIVED
CK'D BY T.Y. Lin International OK'D BY J. Olund
January 24, 2017
RESUBMIT No Approved
BY D. Bonneau DATE 01/25/17

1-3-17 REVISED AS NOTED

T.Y. LIN INTERNATIONAL
THE STAMPED DOCUMENTS ARE HEREBY:
x APPROVED
APPROVED AS NOTED
REVISE AND RESUBMIT
SEE TRANSMITTAL FOR ADDITIONAL INFORMATION AS APPLICABLE.
THIS REVIEW IS FOR GENERAL CONFORMANCE WITH DESIGN CONCEPT ONLY. ANY DEVIATION FROM THE PLANS OR SPECIFICATIONS NOT CLEARLY NOTED BY THE CONTRACTOR HAS NOT BEEN REVIEWED. REVIEW BY THE ENGINEER SHALL NOT RELIEVE THE CONTRACTOR OF THE CONTRACTUAL RESPONSIBILITY FOR ANY ERRORS OR DEVIATION FROM THE CONTRACT REQUIREMENTS.
JOSH OLUND REVIEWER — January 25, 2017 DATE

APPROVAL STAMP:

J.P. CARRARA & SONS INC.
Precast & Prestress Manufacturer
2464 CASE STR., MIDDLEBURY, VERMONT 05753 Phone:(802)388-6361 Fax:(802)388-9010

J.P. SICARD, INC.
CONTRACTOR
BARTON, VERMONT

STATE OF VERMONT AGENCY OF TRANSPORTATION
COUNTY OF ORLEANS

VILLAGE OF BARTON
TH 4 (ROARING BROOK RD.), RURAL MINOR COLLECTOR
BRIDGE NO.: 58 PROJECT NO.: BO 1449(33)

SUPERSTRUCTURE SECTIONS & DETAILS

DATE: NOV. 18, 2016
SCALE: NOTED
CHKD: A.S. DFTM: B.L.
JOB NO: 23498-016
DWG. NO: F3
ROARING BROOK RD.

F:\VT-Bridges\23498-16 Barton\Roaring Brook\Roaring-F3.dwg, 1/4/2017 4:30:50 PM