STATE OF VERMONT
AGENCY OF TRANSPORTATION

TRAFFIC SIGN SUMMARY SHEET 6

LYNDON
S WHEELOCK RD

DIRECTION	MILEMARKER, STATION, OR SIGN NUMBER	LOCATION	MANUAL ON UNIFORM TRAFFIC DEVICES OR STATE CODE	SIGN DIMENSIONS WIDTH	SIGN DIMENSIONS HEIGHT	SHEETING REMARKS	SIGN LEGEND	NEW SIGNS "A"	NEW SIGNS "B"	EXISTING SIGNS RETAIN	EXISTING SIGNS SALVAGE FROM	EXISTING SIGNS SALVAGE TO	EXISTING SIGNS REMOVE	EXISTING POST RETAIN	EXISTING POST REMOVE	NO. OF NEW POSTS	SQUARE STEEL (in) 1.75 lb/ft 1.88	SQUARE STEEL (in) 2.00 lb/ft 2.42	SQUARE STEEL (in) 2.50 lb/ft 3.35	TUBULAR STEEL O/(in) FOUNDATION	TUBULAR STEEL O/(in) 3.00 lb/ft 7.60	TUBULAR STEEL O/(in) 3.50 lb/ft 9.00	TUBULAR STEEL O/(in) 4.00 lb/ft 10.80	TUBULAR STEEL O/(in) 5.00 lb/ft 14.60	SIGN FRAME REQUIRED	REMARKS SHSM = STANDARD HIGHWAY SIGN & MARKING BOOK	SIGN DETAIL DETAIL IN SHSM	SIGN DETAIL DETAIL ON SHEET NUMBER	SIGN DETAIL STANDARD SHEET NUMBER
SB	MM 3.874, LT.	F	W1-2L	30	30			6.25								1.00		15								INSTALL NEW W1-2 SIGN AND POST. LOCATE IT 1172' SOUTH OF WHEELOCK / LYNDON TOWN LINE	X		
SB	MM 4.070, LT.	F	R2-1	24	30								X		X											REMOVE EXISTING R2-1 SIGN AND POST LOCATED 140' SOUTH OF WHEELOCK / LYNDON TOWN LINE			
SB	MM 4.089, LT.	F	TOWN SIGN	24	30								X		X											REMOVE EXISTING SIGN AND POST LOCATED 40' SOUTH OF WHEELOCK / LYNDON TOWN LINE			
SB	MM 4.096, ~~LT.~~ RT	F	R2-1	24	30			5.00					X		X	1.00		15								INSTALL NEW R2-1 SIGN AND POST LOCATED AT THE WHEELOCK / LYNDON TOWN LINE	X		
SB	MM 4.096, LT.	G	D3-1	30	6							X	X		~~X~~ 2	1.00		15								REMOVE EXISTING SIGN AND POST LOCATED AT THE WHEELOCK / LYNDON TOWN LINE			
NB	MM 4.096, RT.	C	VD-024	72	10		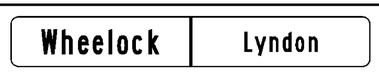	5.00								2.00		30								INSTALL NEW SIGN AND POSTS AT THE TOWN LINE		11	
NB	MM ~~4.096, RT.~~ 4.070, LT	A	R2-1	24	30			5.00								1.00		15								INSTALL NEW SIGN AND POSTS AT THE TOWN LINE			
							FALL BROOK RD																						
EB	MM 0.010, RT.	A	R2-1	24	30			5.00					X		X	1.00		15								REPLACE EXISTING SIGN AND POSTS LOCATED 50' EAST OF INTERSECTION	X		
										EA	EA	EA	EA	EA	EA		FT	FT	FT										
												I	5		~~5~~ 6			~~90~~ 105											
								SF 26.25	SF	EA ~~5~~ 6				EA ~~5~~ 6		EA ~~6~~ 7	FT ~~90~~ 105			EA	LB	LB	LB	LB					

FINAL POST LENGTHS ARE TO BE DETERMINED IN THE FIELD. POST SIZES ARE COMPUTED BASED ON INFORMATION FURNISHED ON THE STANDARD SHEETS AND THE VTRANS "SIGN POST DESIGN GUIDE".

PROJECT NAME: STATEWIDE NORTHEAST REGION
PROJECT NUMBER: STP HRRR(12)

FILE NAME: 12k018wrk.dgn
PROJECT LEADER: JLS
DESIGNED BY: NLA
DRAWN BY: TDS
CHECKED BY: NLA
PLOT DATE: 11-JUL-2012
LYNDON TRAFFIC SIGN SUMMARY SHEET 6
SHEET 31 OF 52