STATE OF VERMONT
AGENCY OF TRANSPORTATION

TRAFFIC SIGN SUMMARY SHEET 4

WILLIAMSTOWN
GRANITEVILLE RD

DIRECTION	MILEMARKER, STATION, OR SIGN NUMBER	LOCATION	MANUAL ON UNIFORM TRAFFIC DEVICES OR STATE CODE	SIGN DIMENSIONS WIDTH	SIGN DIMENSIONS HEIGHT	SHEETING REMARKS	SIGN LEGEND	NEW SIGNS "A"	NEW SIGNS "B"	EXISTING SIGNS RETAIN	EXISTING SIGNS SALVAGE FROM	EXISTING SIGNS SALVAGE TO	EXISTING SIGNS REMOVE	EXISTING POST RETAIN	EXISTING POST REMOVE	NO. OF NEW POSTS	SQUARE STEEL (in) 1.75 lb/ft 1.88	SQUARE STEEL (in) 2.00 lb/ft 2.42	SQUARE STEEL (in) 2.50 lb/ft 3.35	TUBULAR STEEL O (in) FOUNDATION	TUBULAR STEEL O (in) 3.00 lb/ft 7.60	TUBULAR STEEL O (in) 3.50 lb/ft 9.00	TUBULAR STEEL O (in) 4.00 lb/ft 10.80	TUBULAR STEEL O (in) 5.00 lb/ft 14.60	SIGN FRAME REQUIRED	REMARKS SHSM = STANDARD HIGHWAY SIGN & MARKING BOOK	SIGN DETAIL DETAIL IN SHSM	SIGN DETAIL DETAIL ON SHEET NUMBER	SIGN DETAIL STANDARD SHEET NUMBER
WB	MM 1.037, LT.	F	W1-1L	30	30								X		X												REMOVE THE EXISTING W1-1 SIGN AND POST, LOCATED 180' EAST OF POLE # GMP/75			
		F	W13-1	18	18								X		X												REMOVE THE EXISTING W13-1 BELOW THE EXISTING W1-1 LOCATED 180' EAST OF POLE # GMP/75			
EB	MM 1.233, RT.	A	R2-1	24	30			5.00					X		X	1.00		15								REPLACE THE EXISTING R2-1 SIGN AND POST, LOCATED 37' WEST OF POLE # GMP/69/39	X		
EB	MM 1.300, RT.	A B	D3-1	30	8								X		X												REMOVE THE EXISTING D3-1 SIGN AND POST LOCATED AT THE SOUTHWEST CORNER OF GILBERT RD			
EB	MM 1.305, RT.	A B	D3-1	42	12			3.50																			INSTALL A NEW D3-1 SIGN ABOVE THE R1-1 SIGN LOCATED AT THE NORTHWEST CORNER OF GILBERT RD		12	
		D	R1-1	30	30			6.25					X		X	1.00		15								REPLACE THE EXISTING R1-1 SIGN AND POST LOCATED AT THE NORTHWEST CORNER OF GILBERT RD	X		
EB	MM 1.394, RT.	C	R2-1	24	30			5.00					X		X	1.00		15								REPLACE THE EXISTING R2-1 SIGN AND POST LOCATED ON THE SOUTHWEST CORNER OF MARTIN RD	X		
EB	MM 1.402, RT.	A B	D3-1	24	8								2 X		X												REMOVE THE EXISTING D3-1 SIGN AND POST LOCATED ON THE NORTHWEST CORNER OF MARTIN RD			
EB	MM 1.402, RT.	A B	D3-1	42	12			3.50																			INSTALL A NEW D3-1 SIGN ABOVE THE R1-1 SIGN LOCATED ON THE NORTHWEST CORNER OF MARTIN RD		12	
EB	MM 1.402, RT.	D	R1-1	30	30			6.25					X		X	1.00		15								REPLACE THE EXISTING R1-1 SIGN AND POST LOCATED ON THE NORTHWEST CORNER OF MARTIN RD	X		
~~WB~~	~~MM 1.473, LT.~~	~~H~~	~~R1-1~~	~~30~~	~~30~~								~~X~~		~~X~~												REMOVE THE EXISTING R1-1 SIGN AND POST LOCATED ON THE SOUTHEASTERN CORNER OF MCGLYNN RD			
WB	MM 1.473, LT.	E F	D3-1	48	12		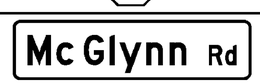	4.00					X		X	2.00		30								INSTALL A NEW D3-1 SIGN ADJACENT TO THE R1-1 SIGN LOCATED ON THE SOUTHEASTERN CORNER OF MCGLYNN RD ON 2 POSTS		12	
		D	R1-1	30	30			6.25					X		X	1.00		15								INSTALL A NEW R1-1 SIGN AND POST LOCATED ON THE SOUTHEASTERN CORNER OF MCGLYNN RD	X		
								SF 39.75	SF	EA ~~10~~ 11				EA 10		EA ~~6~~ 7	FT ~~90~~ 105			EA	LB						

FINAL POST LENGTHS ARE TO BE DETERMINED IN THE FIELD. POST SIZES ARE COMPUTED BASED ON INFORMATION FURNISHED ON THE STANDARD SHEETS AND THE VTRANS "SIGN POST DESIGN GUIDE".

PROJECT NAME: STATEWIDE NORTHEAST REGION
PROJECT NUMBER: STP HRRR(12)

FILE NAME: 12k018wrk.dgn
PROJECT LEADER: JLS
DESIGNED BY: NLA
PLOT DATE: 11-JUL-2012
DRAWN BY: TDS
CHECKED BY: NLA