STATE OF VERMONT
AGENCY OF TRANSPORTATION

TRAFFIC SIGN SUMMARY SHEET 3

HYDE PARK
CRICKET HILL RD

DIRECTION	MILEMARKER, STATION, OR SIGN NUMBER	LOCATION	MANUAL ON UNIFORM TRAFFIC DEVICES OR STATE CODE	SIGN DIMENSIONS WIDTH	SIGN DIMENSIONS HEIGHT	SHEETING REMARKS	SIGN LEGEND	NEW SIGNS "A"	NEW SIGNS "B"	EXISTING SIGNS RETAIN	EXISTING SIGNS SALVAGE FROM	EXISTING SIGNS SALVAGE TO	EXISTING SIGNS REMOVE	EXISTING POST RETAIN	EXISTING POST REMOVE	NO. OF NEW POSTS	SQUARE STEEL (in) lb/ft 1.75 (1.88)	SQUARE STEEL (in) lb/ft 2.00 (2.42)	SQUARE STEEL (in) lb/ft 2.50 (3.35)	TUBULAR STEEL O/(in) FOUNDATION	TUBULAR STEEL O/(in) lb/ft 3.00 (7.60)	TUBULAR STEEL O/(in) lb/ft 3.50 (9.00)	TUBULAR STEEL O/(in) lb/ft 4.00 (10.80)	TUBULAR STEEL O/(in) lb/ft 5.00 (14.60)	SIGN FRAME REQUIRED	REMARKS SHSM = STANDARD HIGHWAY SIGN & MARKING BOOK	SIGN DETAIL DETAIL IN SHSM	SIGN DETAIL DETAIL ON SHEET NUMBER	SIGN DETAIL STANDARD SHEET NUMBER
EB	MM 0.847, RT.	A	W1-8L	18	24			3.00								1.00		12.5 ~~15~~								INSTALL NEW W1-8 SIGNS ON A NEW BRACKET AND POST. LOCATE IT 106' EAST OF POLE # 9 / NET / 8	X		
		B	W1-8R	18	24			3.00																				
EB	MM 0.878, RT.	A	W1-8L	18	24		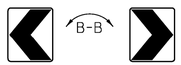	3.00								1.00		12.5 ~~15~~								INSTALL NEW W1-8 SIGNS ON A NEW BRACKET AND POST. LOCATE IT 15' WEST OF POLE # 8 / 7	X		
		B	W1-8R	18	24			3.00																				
EB	MM 0.912, RT.	A	W1-8L	18	24			3.00								1.00		12.5 ~~15~~								INSTALL NEW W1-8 SIGNS ON A NEW BRACKET AND POST. LOCATE IT 115' WEST OF POLE # 7 / 6	X		
		B	W1-8R	18	24			3.00																				
WB	MM 0.935, LT.	F	S3-1	36	36	TYPE IX		9.00					X		X	2.00		14.0 14.0 ~~30~~								REPLACE EXISTING S3-1 SIGN AND POSTS LOCATED 25' WEST AND ACROSS FROM POLE # 7 / 6	X		
EB	MM 0.980, RT.	A	TOWN SIGN	12	18								X		X											REMOVE EXISTING TOWN SIGN LOCATED ACROSS FROM POLE # 6			
WB	MM 1.075, LT.	F	TOWN SIGN	12	18								X		X											REMOVE EXISTING TOWN SIGN LOCATED 10' EAST OF POLE # 4 / 3			
		F	W1-5R	30	30			6.25								1.00		16 ~~15~~								INSTALL NEW W1-5 SIGN AND POST. LOCATE IT 10' EAST OF POLE # 6	X		
			W7-3A	24	18			3.00																			INSTALL NEW W7-3A SIGN BELOW THE W1-5 SIGN LOCATED 10' EAST OF POLE # 6			
EB	MM 1.188, RT.	A	W3-1	30	30			6.25								1.00		14.0 ~~15~~								INSTALL NEW W3-1 SIGN AND POST 30' EAST OF POLE # 2 / 19 / 4 / 3 / 1	X		
										EA	EA	EA	EA	EA	EA		FT	FT	FT		LB	LB	LB	LB					
													3		3			~~105~~											
								SF 42.50	SF	EA 3				EA 3		EA 7	FT ~~105~~ 95.5			EA	LB								

FINAL POST LENGTHS ARE TO BE DETERMINED IN THE FIELD. POST SIZES ARE COMPUTED BASED ON INFORMATION FURNISHED ON THE STANDARD SHEETS AND THE VTRANS "SIGN POST DESIGN GUIDE".

PROJECT NAME: STATEWIDE NORTHWEST REGION
PROJECT NUMBER: STP HRRR(13)

FILE NAME: 12k020wrk.dgn **PLOT DATE:** 16-JUL-2012
PROJECT LEADER: JLS **DRAWN BY:** TDS
DESIGNED BY: NLA **CHECKED BY:** NLA
HYDE PARK TRAFFIC SIGN SUMMARY SHEET 3 **SHEET** 35 **OF** 107