STATE OF VERMONT
AGENCY OF TRANSPORTATION

TRAFFIC SIGN SUMMARY SHEET 5

SHELDON - HIGHGATE - FRANKLIN
RICE HILL RD

DIRECTION	MILEMARKER, STATION, OR SIGN NUMBER	LOCATION	MANUAL ON UNIFORM TRAFFIC DEVICES OR STATE CODE	SIGN DIMENSIONS WIDTH	SIGN DIMENSIONS HEIGHT	SHEETING REMARKS	SIGN LEGEND	NEW SIGNS "A"	NEW SIGNS "B"	EXISTING SIGNS RETAIN	EXISTING SIGNS SALVAGE FROM	EXISTING SIGNS SALVAGE TO	EXISTING SIGNS REMOVE	EXISTING POST RETAIN	EXISTING POST REMOVE	NO. OF NEW POSTS	SQUARE STEEL (in) lb/ft 1.75 (1.88)	SQUARE STEEL (in) lb/ft 2.00 (2.42)	SQUARE STEEL (in) lb/ft 2.50 (3.35)	TUBULAR STEEL O/(in) FOUNDATION	TUBULAR STEEL O/(in) lb/ft 3.00 (7.60)	TUBULAR STEEL O/(in) lb/ft 3.50 (9.00)	TUBULAR STEEL O/(in) lb/ft 4.00 (10.80)	TUBULAR STEEL O/(in) lb/ft 5.00 (14.60)	SIGN FRAME REQUIRED	REMARKS (SHSM = STANDARD HIGHWAY SIGN & MARKING BOOK)	SIGN DETAIL IN SHSM	SIGN DETAIL ON SHEET NUMBER	SIGN DETAIL STANDARD SHEET NUMBER
SB	MM 2.398, LT.	F	W1-2L	30	30			6.25								1.00		15								INSTALL A NEW W1-2 SIGN AND POST. LOCATE IT 496' NORTH AND ACROSS FROM POLE # VTELEC / 99C / 59	X		
NB	MM 3.216, RT.	A	S3-1	30	30								X		X											REMOVE THE EXISTING S3-1 SIGN AND POSTS LOCATED 444' SOUTH OF MAIL BOX # 3276			
NB	MM 3.236, RT.	A	W1-2L	30	30								X		X											REMOVE THE EXISTING W1-2 SIGN AND POST. LOCATE IT 338' SOUTH OF MAIL BOX 3276			
NB	MM 3.275, RT.	A	W1-2L	30	30			6.25								1.00		14.0 ~~15~~								INSTALL A NEW W1-2 L SIGN AND POST. LOCATE IT 130' SOUTH OF MAIL BOX 3276	X		
NB	MM 3.306, RT.	A	R2-1	24	30			5.00								1.00		13.0 ~~15~~								INSTALL A NEW R2-1 SIGN AND POST. LOCATE IT 32' NORTH OF MAIL BOX 3276	X		
SB	MM 3.306, LT.	F	R2-1	24	30			5.00			1		X		X	1.00		13.0 ~~15~~								REPLACE THE EXISTING R2-1 SIGN AND POST. LOCATE IT 32' NORTH AND ACROSS MAIL BOX 3276	X		
SB	MM 3.307, LT.	G	VD-024	72	10		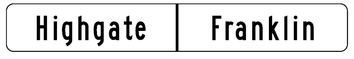	5.00								2.00		11.0 ~~30~~ 11.0								INSTALL A NEW VD-024 SIGN AND POSTS. LOCATE IT 35' NORTH AND ACROSS MAIL BOX 3276		14	
NB	MM 3.330, RT.	A	W1-6L	48	24			8.00								2.00		13.0 ~~30~~ 13.0								INSTALL A NEW W1-6 SIGN AND POSTS LOCATED 190' SOUTH AND ACROSS FROM POLE # VTELEC / 99 / 245L	X		
NB	MM 3.330, RT.	B	W1-6R	48	24			8.00								2.00		17.0 30 13.0								INSTALL A NEW W1-6 SIGN AND POSTS LOCATED 185' SOUTH AND ACROSS FROM POLE # VTELEC / 99 / 245L	X		
										EA	EA	EA	EA 3	EA	EA 3		FT	FT 150	FT		LB	LB	LB	LB					
								SF 43.50	SF	EA 1 ~~3~~ 3				EA 3		EA 10	FT ~~150~~ 129			EA	LB								

FINAL POST LENGTHS ARE TO BE DETERMINED IN THE FIELD. POST SIZES ARE COMPUTED BASED ON INFORMATION FURNISHED ON THE STANDARD SHEETS AND THE VTRANS "SIGN POST DESIGN GUIDE".

PROJECT NAME: STATEWIDE NORTHWEST REGION
PROJECT NUMBER: STP HRRR(13)

FILE NAME: 12k020wrk.dgn
PROJECT LEADER: JLS
DESIGNED BY: NLA
PLOT DATE: 16-JUL-2012
DRAWN BY: TDS
CHECKED BY: NLA
SHELDON-HIGHGATE-FRANKLIN TSS SHEET 5
SHEET 42 **OF** 107