STATE OF VERMONT
AGENCY OF TRANSPORTATION

TRAFFIC SIGN SUMMARY SHEET 2

WALTHAM - FERRISBURGH - NEW HAVEN - BRISTOL
PLANK RD

DIRECTION	MILEMARKER, STATION, OR SIGN NUMBER	LOCATION	MANUAL ON UNIFORM TRAFFIC DEVICES OR STATE CODE	SIGN DIMENSIONS WIDTH	SIGN DIMENSIONS HEIGHT	SHEETING REMARKS	SIGN LEGEND	NEW SIGNS "A"	NEW SIGNS "B"	EXISTING SIGNS RETAIN	EXISTING SIGNS SALVAGE FROM	EXISTING SIGNS SALVAGE TO	EXISTING SIGNS REMOVE	EXISTING POST RETAIN	EXISTING POST REMOVE	NO. OF NEW POSTS	SQUARE STEEL (in) 1.75 lb/ft 1.88	SQUARE STEEL (in) 2.00 lb/ft 2.42	SQUARE STEEL (in) 2.50 lb/ft 3.35	TUBULAR STEEL O/(in) FOUNDATION	TUBULAR STEEL O/(in) 3.00 lb/ft 7.60	TUBULAR STEEL O/(in) 3.50 lb/ft 9.00	TUBULAR STEEL O/(in) 4.00 lb/ft 10.80	TUBULAR STEEL O/(in) 5.00 lb/ft 14.60	SIGN FRAME REQUIRED	REMARKS SHSM = STANDARD HIGHWAY SIGN & MARKING BOOK	SIGN DETAIL DETAIL IN SHSM	SIGN DETAIL DETAIL ON SHEET NUMBER	SIGN DETAIL STANDARD SHEET NUMBER
EB	MM 1.021, RT.	A	W2-1	30	30			6.25								1.00		14.0 ~~15~~								INSTALL NEW W2-1 SIGN AND POST LOCATED ACROSS FROM POLE # GMP / 3	X		
		A	W16-8P	42	8			2.35					1													INSTALL NEW W16-8P SIGN BELOW THE W2-1 SIGN LOCATED ACROSS FROM POLE # GMP / 3		16	
WB	MM 1.100, LT.	H	R1-1	30	30			6.25				1	X		X	1.00		14.0 ~~15~~								REPLACE THE EXISTING R1-1 SIGN AND POST LOCATED ON THE SOUTHWEST CORNER OF S MIDDLEBROOK RD	X		
WB	MM 1.100 LT. + 300 FT.	H	W3-1	30	30			6.25								1.00		14.0 ~~15~~								INSTALL NEW W3-1 SIGN AND POST. LOCATE IT 300' NORTH OF R1-1 ASSEMBLYTHAT IS ON THE SOUTHWEST CORNER OF S MIDDLEBROOK RD	X		
EB	MM 1.101, RT.	D	R1-1	30	30			6.25					X		X	1.00		13.0 ~~15~~								REPLACE THE EXISTING R1-1 SIGN AND POST LOCATED ON THE NORTHEAST CORNER OF S MIDDLEBROOK RD	X		
EB	MM 1.101 RT. + 300 FT.	D	W3-1	30	30			6.25					1			1.00		14.0 ~~15~~								INSTALL NEW W3-1 SIGN AND POST. LOCATE IT 300' SOUTH OF R1-1 ASSEMBLY THAT IS ON THE NORTHEAST CORNER OF S MIDDLEBROOK RD	X		
WB	MM 1.160, LT.	F	W2-1	30	30			6.25								1.00		15								INSTALL A NEW W2-1 SIGN AND POST 260' EAST OF POLE # GMP / 50 / NET / 3	X		
		F	W16-8P	42	8			2.35																		INSTALL A NEW W16-8P SIGN BELOW THE W2-1 SIGN LOCATED 260' EAST OF POLE # GMP / 50 / NET / 3		16	
EB	MM 1.200, RT.														X											REMOVE EXISTING POST LOCATED 212' EAST AND ACROSS FROM POLE # GMP / 2 / NET / 14			
EB	MM 1.200, RT.	C	VD-024	72	10		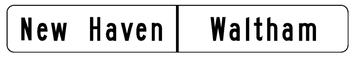	5.00							X	2.00		12.0 ~~30~~								REMOVE EMPTY POST AT THIS LOCATION AND INSTALL A NEW VD-024 SIGN AND POST LOCATED 212' EAST AND ACROSS FROM POLE # GMP / 2 / NET / 14		16	
EB	MM 1.430, RT.	A	W10-1	36 DIAM.				7.07								2.00		30								INSTALL A NEW W10-1 SIGN AND POSTS,LOCATE IT 80' WEST AND ACROSS FROM POLE# GMP / 10	X		
WB	MM 1.616, LT.	F	W10-1	36 DIAM.				7.07								2.00		14.0 ~~30~~ 14.0								INSTALL A NEW W10-1 SIGN AND POSTS,LOCATE IT 32' EAST OF POLE# GMP / 15	X		
										EA	EA	EA	EA ~~2~~	EA	EA 4		FT	FT ~~180~~	FT		LB	LB	LB	LB					
								SF 61.34	SF	EA ~~2~~ 7				EA 4		EA 12	FT ~~180~~ 154			EA	LB								

FINAL POST LENGTHS ARE TO BE DETERMINED IN THE FIELD. POST SIZES ARE COMPUTED BASED ON INFORMATION FURNISHED ON THE STANDARD SHEETS AND THE VTRANS "SIGN POST DESIGN GUIDE".

PROJECT NAME: STATEWIDE NORTHWEST REGION
PROJECT NUMBER: STP HRRR(13)

FILE NAME: 12k020wrk.dgn
PROJECT LEADER: JLS
DESIGNED BY: NLA
PLOT DATE: 16-JUL-2012
DRAWN BY: TDS
CHECKED BY: NLA