STATE OF VERMONT
AGENCY OF TRANSPORTATION

TRAFFIC SIGN SUMMARY SHEET 8

WALTHAM - FERRISBURGH - NEW HAVEN - BRISTOL
PLANK RD

DIRECTION	MILEMARKER, STATION, OR SIGN NUMBER	LOCATION	MANUAL ON UNIFORM TRAFFIC DEVICES OR STATE CODE	SIGN DIMENSIONS WIDTH	SIGN DIMENSIONS HEIGHT	SHEETING REMARKS	SIGN LEGEND	NEW SIGNS "A"	NEW SIGNS "B"	EXISTING SIGNS RETAIN	EXISTING SIGNS SALVAGE FROM	EXISTING SIGNS SALVAGE TO	EXISTING SIGNS REMOVE	EXISTING POST RETAIN	EXISTING POST REMOVE	NO. OF NEW POSTS	SQUARE STEEL (in) 1.75 lb/ft 1.88	SQUARE STEEL (in) 2.00 lb/ft 2.42	SQUARE STEEL (in) 2.50 lb/ft 3.35	TUBULAR STEEL O/(in) FOUNDATION	TUBULAR STEEL O/(in) 3.00 lb/ft 7.60	TUBULAR STEEL O/(in) 3.50 lb/ft 9.00	TUBULAR STEEL O/(in) 4.00 lb/ft 10.80	TUBULAR STEEL O/(in) 5.00 lb/ft 14.60	SIGN FRAME REQUIRED	REMARKS SHSM = STANDARD HIGHWAY SIGN & MARKING BOOK	SIGN DETAIL DETAIL IN SHSM	SIGN DETAIL DETAIL ON SHEET NUMBER	SIGN DETAIL STANDARD SHEET NUMBER
EB	MM 4.378, RT. TO MM 4.459, RT.	AB		6	8		(14) TYPE II - 6" x 8" WHITE DELINEATORS									7		63								INSTALL NEW DELINEATORS (14) BACK - TO - BACK 60' APART ON 7 POSTS, INSTALL FIRST POST 2418' EAST OF NORTH ST.		5	
WB	MM 4.480, LT.	F	W1-2R	30	30			6.25								1.00		15								INSTALL A NEW W1-2 SIGN AND POST. LOCATE IT 20' WEST OF FIELD DRIVE LOCATED 1320' WEST OF NEW HAVEN / BRISTOL TOWN LINE	X		
EB	MM 4.690, RT.	A	W1-1R	30	30			6.25								1.00		16.0 ~~15~~								INSTALL A NEW W1-1R SIGN AND POST. LOCATE IT 210' WEST AND ACROSS FROM THE NEW HAVEN / BRISTOL TOWN LINE SIGN	X		
		A	W13-1	18	18			2.25																		INSTALL A NEW W13-1 SIGN BELOW THE W1-1L SIGN LOCATED 210' WEST AND ACROSS FROM THE NEW HAVEN / BRISTOL TOWN LINE SIGN	X		
WB	MM 4.726, LT.	F	R2-1	24	30			5.00					X		X	1.00		13.0 ~~15~~								REPLACE THE EXISTING R2-1 SIGN AND POST. LOCATE IT 25' WEST OF THE NEW HAVEN / BRISTOL TOWN LINE SIGN	X		
WB	MM 4.727, LT. TO MM 4.810, LT.	E F		6	8		(16) TYPE II - 6" x 8" WHITE DELINEATORS											72								INSTALL NEW DELINEATORS (16) BACK - TO - BACK 50' APART ON 8 POSTS, INSTALL FIRST POST 25' WEST OF THE NEW HAVEN / BRISTOL TOWN LINE SIGN		5	
WB	MM 4.730, LT.	G	VD-024	72	10		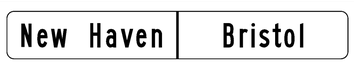	5.00					X		X	2.00		12.0 ~~30~~ 12.0								REPLACE THE EXISTING VD-024 SIGN ON 2 POSTS. LOCATE IT AT THE TOWN LINE OF NEW HAVEN / BRISTOL		16	
WB	MM 4.755, LT.	E	W1-6R	48	24			8.00					2			2.00		30								INSTALL A NEW W1-6 SIGN AND POSTS. LOCATE IT 137' EAST OF THE TOWN LINE OF NEW HAVEN / BRISTOL	X		
WB	MM 4.757, LT.	F	W1-6L	48	24			8.00								2.00		30								INSTALL A NEW W1-6 SIGN AND POSTS. LOCATE IT 140' EAST OF THE TOWN LINE OF NEW HAVEN / BRISTOL	X		
WB	MM 4.780, LT.	E	W1-6R	48	24			8.00								2.00		30								INSTALL A NEW W1-6 SIGN AND POSTS. LOCATE IT 265' EAST OF THE TOWN LINE OF NEW HAVEN / BRISTOL	X		
WB	MM 4.782, LT.	F	W1-6L	48	24		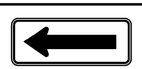	8.00								2.00		30								INSTALL A NEW W1-6 SIGN AND POSTS. LOCATE IT 270' EAST OF THE TOWN LINE OF NEW HAVEN / BRISTOL	X		
WB	MM 4.788, LT.	F	W1-8L	18	24								X		X											REMOVE EXISTING CHEVRON AND POST LOCATED 306' EAST OF THE TOWN LINE OF NEW HAVEN / BRISTOL			
										EA	EA	EA	EA ~~3~~	EA	EA 3		FT	FT ~~195~~	FT		LB	LB	LB	LB					
							30 DELINEATORS	SF 56.75	SF	EA ~~3~~ 5				EA 3		EA 13	FT ~~195~~ 323			EA	LB								

FINAL POST LENGTHS ARE TO BE DETERMINED IN THE FIELD. POST SIZES ARE COMPUTED BASED ON INFORMATION FURNISHED ON THE STANDARD SHEETS AND THE VTRANS "SIGN POST DESIGN GUIDE".

PROJECT NAME: STATEWIDE NORTHWEST REGION
PROJECT NUMBER: STP HRRR(13)

FILE NAME: 12k020wrk.dgn
PROJECT LEADER: JLS
DESIGNED BY: NLA
PLOT DATE: 16-JUL-2012
DRAWN BY: TDS
CHECKED BY: NLA