STATE OF VERMONT
AGENCY OF TRANSPORTATION

TRAFFIC SIGN SUMMARY SHEET 3

BURLINGTON
ROUTE 127

DIRECTION	MILEMARKER, STATION, OR SIGN NUMBER	LOCATION	MANUAL ON UNIFORM TRAFFIC DEVICES OR STATE CODE	SIGN DIMENSIONS WIDTH	SIGN DIMENSIONS HEIGHT	SHEETING REMARKS	SIGN LEGEND	NEW SIGNS "A"	NEW SIGNS "B"	EXISTING SIGNS RETAIN	EXISTING SIGNS SALVAGE FROM	EXISTING SIGNS SALVAGE TO	EXISTING SIGNS REMOVE	EXISTING POST RETAIN	EXISTING POST REMOVE	NO. OF NEW POSTS	SQUARE STEEL (in) 1.75 lb/ft 1.88	SQUARE STEEL (in) 2.00 lb/ft 2.42	SQUARE STEEL (in) 2.50 lb/ft 3.35	TUBULAR STEEL O/(in) FOUNDATION	TUBULAR STEEL O/(in) 3.00 lb/ft 7.60	TUBULAR STEEL O/(in) 3.50 lb/ft 9.00	TUBULAR STEEL O/(in) 4.00 lb/ft 10.80	TUBULAR STEEL O/(in) 5.00 lb/ft 14.60	SIGN FRAME REQUIRED	REMARKS (SHSM = STANDARD HIGHWAY SIGN & MARKING BOOK)	SIGN DETAIL: DETAIL IN SHSM	SIGN DETAIL: DETAIL ON SHEET NUMBER	SIGN DETAIL: STANDARD SHEET NUMBER
SB	MM 0.127, LT.	F	W3-3	30	30								X		X												REMOVE SIGN AND POST LOCATED 538 FT NORTH AND ACROSS LIGHT POLE # 10894.			
		F	VR-943	36	30		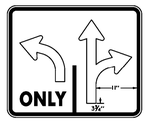						X														REMOVE SIGN BELOW THE SIGNAL AHEAD SIGN LOCATED 538 FT NORTH AND ACROSS LIGHT POLE # 10894.			
SB	MM 0.183, LT.	F	W2-1	36	36			9.00								2.00		30								INSTALL NEW SIGN AND POST 834 FT NORTH AND ACROSS LIGHT POLE # 10894.	X		
		F	W16-8P	36	8			2.00																		INSTALL NEW SIGN BELOW THE SIGNAL AHEAD SIGN LOCATED 834 FT NORTH AND ACROSS LIGHT POLE # 10894.		86	
SB	MM 0.189, LT.	F	D12-2M	72	48						X				X												REMOVE SIGN AND POSTS LOCATED 865 FT NORTH AND ACROSS LIGHT POLE # 10894 AND REINSTALL SIGN ON NEW POST AT 0.221.			
SB	MM 0.200, LT.	F	VD-700	6	10					X				X												RETAIN MILE MARKER AT SAME LOCATION 1056 FT FROM THE CENTER OF MANHATTAN DRIVE.			
SB	MM 0.221, LT.	F	D12-2M	72	48							~~X~~				2.00				2.00	30					INSTALL SIGN FROM 0.189 ON NEW POSTS AT NEW LOCATION 1034 FT NORTH AND ACROSS LIGHT POLE # 10894.			
SB	MM 0.796, LT.	F	VW-218	36	36			9.00								2.00		30								INSTALL NEW SIGN ON 2 POSTS 200 FT IN ADVANCE OF THE BEGINNNG OF THE CENTERLINE RUMBLE		86	
								EA 1	EA 1	EA 1	EA 2	EA 1	EA 2				FT 60		FT	LB 30	LB	LB	LB					
								SF 20.00	SF	EA 1 ~~5~~ 2		EA 3		EA 4	FT 60		EA 2	LB 30								

FINAL POST LENGTHS ARE TO BE DETERMINED IN THE FIELD. POST SIZES ARE COMPUTED BASED ON INFORMATION FURNISHED ON THE STANDARD SHEETS AND THE VTRANS "SIGN POST DESIGN GUIDE".

PROJECT NAME: STATEWIDE NORTHEAST REGION
PROJECT NUMBER: HES HSIP(4)

FILE NAME: 12k018wrk.dgn (12k038) **PLOT DATE:** 16-JUL-2012
PROJECT LEADER: JLS **DRAWN BY:** TDS
DESIGNED BY: NLA **CHECKED BY:** JLS
BURLINGTON TRAFFIC SIGN SUMMARY SHEET 3 **SHEET** 89 **OF** 107