STATE OF VERMONT
AGENCY OF TRANSPORTATION

TRAFFIC SIGN SUMMARY SHEET 3

COLCHESTER
PRIM RD.

DIRECTION	MILEMARKER, STATION, OR SIGN NUMBER	LOCATION	MANUAL ON UNIFORM TRAFFIC DEVICES OR STATE CODE	SIGN DIMENSIONS WIDTH	SIGN DIMENSIONS HEIGHT	SHEETING REMARKS	SIGN LEGEND	NEW SIGNS "A"	NEW SIGNS "B"	EXISTING SIGNS RETAIN	EXISTING SIGNS SALVAGE FROM	EXISTING SIGNS SALVAGE TO	EXISTING SIGNS REMOVE	EXISTING POST RETAIN	EXISTING POST REMOVE	NO. OF NEW POSTS	SQUARE STEEL (in) 1.75 lb/ft 1.88	SQUARE STEEL (in) 2.00 lb/ft 2.42	SQUARE STEEL (in) 2.50 lb/ft 3.35	TUBULAR STEEL O/(in) FOUNDATION	TUBULAR STEEL O/(in) 3.00 lb/ft 7.60	TUBULAR STEEL O/(in) 3.50 lb/ft 9.00	TUBULAR STEEL O/(in) 4.00 lb/ft 10.80	TUBULAR STEEL O/(in) 5.00 lb/ft 14.60	SIGN FRAME REQUIRED	REMARKS (SHSM = STANDARD HIGHWAY SIGN & MARKING BOOK)	SIGN DETAIL: DETAIL IN SHSM	SIGN DETAIL: DETAIL ON SHEET NUMBER	SIGN DETAIL: STANDARD SHEET NUMBER
							W. LAKESHORE DRIVE																						
EB	MM 0.098, RT.	A	VD-503	12	18							X				1.00		15									REINSTALL SIGN SALVAGED FROM LOCATION 68 FT EAST OF POLE # 1-15/2 TO NEW LOCATION 14 FT WEST OF POLE # 1 - 15 / 2.	X		
		A	M6-3	12	9							~~X~~															REINSTALL SIGN SALVAGED BELOW BIKEWAY SIGN FROM LOCATION 68 FT EAST OF POLE # 1-15/2 TO NEW LOCATION 14 FT WEST OF POLE # 1-15/2.			
EB	MM 0.114, RT.	A	VD-503	12	18						X				X												REMOVE SIGN FROM LOCATION 68 FT EAST OF POLE # 1-15/2 AND REINSTALL AT NEW LOCATION 14 FT WEST OF POLE # 1- 15 / 2.			
EB	MM 0.114, RT.	A	M3-1	12	6						~~X~~																REMOVE SIGN FROM LOCATION 68 FT EAST OF POLE # 1-15/2 AND REINSTALL AT NEW LOCATION 14 FT WEST OF POLE # 1-15/2 BELOW BIKEWAY SIGN.			
EB	MM 0.127, RT.	A	M3-1	24	12			2.00								1.00		15									INSTALL NEW SIGN 136 FT EAST OF POLE # 1- 15 / 2. BLACK TEXT AND BORDER ON A WHITE BACKGROUND	X		
		A	M1-6	30	24			5.00																			INSTALL NEW SIGN BELOW THE NEW "NORTH" SIGN.			E-136C
		A	M6-3	21	15			2.19																			INSTALL NEW SIGN BELOW THE NEW 127 SIGN.	X		
		A	M3-3	24	12			2.00										15.0									INSTALL NEW SIGN 136 FT EAST OF POLE # 1-15/2. INSTALL TO THE RIGHT OF THE "NORTH" ASSEMBLY.	X		
		A	M1-6	30	24			5.00																			INSTALL NEW SIGN BELOW THE NEW "SOUTH" SIGN.			E-136C
		A	M6-1	21	15			2.19																			INSTALL NEW SIGN BELOW THE NEW 127 SIGN.	X		
EB	MM 0.135, LT.	E	D3-1	24	6		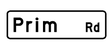						X		X												REMOVE SIGN AND POST LOCATED 48 FT WEST AND ACROSS POLE # 103 / 138.			
EB	MM 0.135, LT.	H	D3-1	36	6		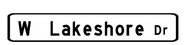						X														REMOVE SIGN BELOW THE PRIM RD STREET NAME SIGN.			
SB	MM 0.146, LT.	G	W1-7	48	24		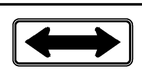	8.00					X		X	2.00		30									REPLACE SIGN AT SAME LOCATION, 6 FT EAST OF POLE # 103/138. INSTALL ON 2 NEW POSTS.	X		
		G	OM1-1	18	18								X														REMOVE THE EXISTING SIGN BELOW THE DOUBLE ARROW SIGN, 6 FT EAST OF POLE #103 / 138.			
								SF 26.38	SF	EA 1 ~~8~~ 4				EA 3		EA 5	FT 75			EA	LB								

FINAL POST LENGTHS ARE TO BE DETERMINED IN THE FIELD. POST SIZES ARE COMPUTED BASED ON INFORMATION FURNISHED ON THE STANDARD SHEETS AND THE VTRANS "SIGN POST DESIGN GUIDE".

EA	EA	EA	EA	EA	EA	FT	FT	FT	LB	LB	LB	LB
	2	2	4		3		75					

PROJECT NAME: STATEWIDE NORTHEAST REGION
PROJECT NUMBER: HES HSIP(4)

FILE NAME: I2k018wrk.dgn (I2Jk038) **PLOT DATE:** 16-JUL-2012
PROJECT LEADER: JLS **DRAWN BY:** TDS
DESIGNED BY: NLA **CHECKED BY:** JLS
COLCHESTER TRAFFIC SIGN SUMMARY SHEET 3 **SHEET** 93 **OF** 107