STATE OF VERMONT
AGENCY OF TRANSPORTATION

TRAFFIC SIGN SUMMARY SHEET 8

BENSON

DIRECTION	MILEMARKER, STATION, OR SIGN NUMBER	LOCATION	MANUAL ON UNIFORM TRAFFIC DEVICES OR STATE CODE	SIGN DIMENSIONS WIDTH	SIGN DIMENSIONS HEIGHT	SHEETING REMARKS	SIGN LEGEND	NEW SIGNS "A"	NEW SIGNS "B"	EXISTING SIGNS RETAIN	EXISTING SIGNS SALVAGE FROM	EXISTING SIGNS SALVAGE TO	EXISTING SIGNS REMOVE	EXISTING POST RETAIN	EXISTING POST REMOVE	NO. OF NEW POSTS	SQUARE STEEL (in) 1.75 lb/ft 1.88	SQUARE STEEL (in) 2.00 lb/ft 2.42	SQUARE STEEL (in) 2.50 lb/ft 3.35	TUBULAR STEEL O/(in) FOUNDATION	TUBULAR STEEL O/(in) 3.00 lb/ft 7.60	TUBULAR STEEL O/(in) 3.50 lb/ft 9.00	TUBULAR STEEL O/(in) 4.00 lb/ft 10.80	TUBULAR STEEL O/(in) 5.00 lb/ft 14.60	SIGN FRAME REQUIRED	REMARKS SHSM = STANDARD HIGHWAY SIGN & MARKING BOOK	SIGN DETAIL DETAIL IN SHSM	SIGN DETAIL DETAIL ON SHEET NUMBER	SIGN DETAIL STANDARD SHEET NUMBER
EB	MM 3.799, RT.	A	W1-McR	30	30			6.25					X		X	1.00		15								REPLACE EXISTING SIGN AND POST LOCATED 53' WEST AND ACROSS FROM POLE # 88.		11	
		A	W13-1	18	18			2.25					X													REPLACE EXISTING SIGN BELOW THE W1-1Mc R SIGN LOCATED 53' WEST AND ACROSS FROM POLE # 88.	X		
WB	MM 3.801, LT.	F	R2-1	24	30			5.00					X		X	1.00		15								REPLACE EXISTING SIGN AND POST LOCATED 42' WEST OF POLE # 88.	X		
EB	MM 3.833, RT.	A		6	8		(1) TYPE II - 6" x 8" WHITE DELINEATOR																			INSTALL (I) DELINEATOR 127' EAST AND ACROSS FROM POLE # 88. PUT BETWEEN THE STONE WALL AND THE DRIVEWAY.		4	
WB	MM 3.834, LT.	EF	D3-1	72	12			6.00					X													REPLACE EXISTING SIGN LOCATED ABOVE THE R1-1 SIGN 132' EAST OF POLE # 88. INSTALL NEW SIGN ADJACENT TO REPLACED R1-1 ON 2-POSTS		11	
		H	R1-1	30	30			6.25					X		X	1.00		15								REPLACE EXISTING SIGN AND POST LOCATED 132' EAST OF POLE # 88.	X		
WB	MM 3.840, LT.	F	W1-6	48	24			8.00								2.00		30								INSTALL NEW SIGN AND POSTS IN ISLAND LOCATED 164' EAST OF POLE # 88.	X		
WB	MM 3.842, LT.	H	R1-1	30	30			6.25					0 ~~X~~		X	1.00		15								REPLACE EXISTING SIGN AND POST LOCATED 174' EAST OF POLE # 88 (IN ISLAND FACING EASTBOUND RAMP TRAFFIC).	X		
WB	MM 3.843, LT.	G	R1-1	30	30			6.25					0 ~~X~~		X	1.00		15								REPLACE EXISTING SIGN AND POST LOCATED 174' EAST OF POLE # 88 (IN ISLAND FACING WESTBOUND RAMP TRAFFIC).	X		
WB	MM 3.847, LT.	E	W1-6	48	24		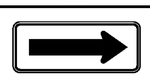	8.00								2.00		30								INSTALL NEW SIGN AND POSTS IN ISLAND LOCATED 201' EAST OF POLE # 88.	X		
WB	MM 3.848, LT.	E	W1-6	48	24		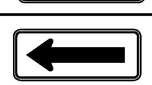	8.00								2.00		30								INSTALL NEW SIGN AND POSTS IN ISLAND LOCATED 205' EAST OF POLE # 88.	X		
WB	MM 3.850, LT.	EF	D3-1	36	12			3.00					X													REPLACE EXISTING SIGN LOCATED ABOVE THE R1-1 SIGN 216' EAST OF POLE # 88.		9	
		H	R1-1	30	30			6.25					2 ~~X~~		X	1.00		15								REMOVED RTE 144 SIGN TOO		REPLACE EXISTING SIGN AND POST LOCATED 216' EAST OF POLE # 88.	X		
	MM 3.847 LT												3																
										EA	EA	EA	EA 9 11	EA	EA 6		FT	FT 210	FT		LB	LB	LB	LB					
								SF 71.50	SF	EA 9 11				EA 6	EA 14		FT ~~210~~ 158.82		EA	LB								

FINAL POST LENGTHS ARE TO BE DETERMINED IN THE FIELD. POST SIZES ARE COMPUTED BASED ON INFORMATION FURNISHED ON THE STANDARD SHEETS AND THE VTRANS "SIGN POST DESIGN GUIDE".

PROJECT NAME: STATEWIDE SOUTHWEST REGION
PROJECT NUMBER: STP HRRR(15)

FILE NAME: I2k024frm.dgn
PROJECT LEADER: JLS
DESIGNED BY: NLA
BENSON TRAFFIC SIGN SUMMARY SHEET 8

PLOT DATE: 06-AUG-2012
DRAWN BY: TDS
CHECKED BY: NLA
SHEET 29 OF 90