STATE OF VERMONT
AGENCY OF TRANSPORTATION

TRAFFIC SIGN SUMMARY SHEET 9

BENSON

DIRECTION	MILEMARKER, STATION, OR SIGN NUMBER	LOCATION	MANUAL ON UNIFORM TRAFFIC DEVICES OR STATE CODE	SIGN DIMENSIONS WIDTH	SIGN DIMENSIONS HEIGHT	SHEETING REMARKS	SIGN LEGEND	NEW SIGNS "A"	NEW SIGNS "B"	EXISTING SIGNS RETAIN	EXISTING SIGNS SALVAGE FROM	EXISTING SIGNS SALVAGE TO	EXISTING SIGNS REMOVE	EXISTING POST RETAIN	EXISTING POST REMOVE	NO. OF NEW POSTS	SQUARE STEEL (in) 1.75 lb/ft 1.88	SQUARE STEEL (in) 2.00 lb/ft 2.42	SQUARE STEEL (in) 2.50 lb/ft 3.35	TUBULAR STEEL O/(in) FOUNDATION	TUBULAR STEEL O/(in) 3.00 lb/ft 7.60	TUBULAR STEEL O/(in) 3.50 lb/ft 9.00	TUBULAR STEEL O/(in) 4.00 lb/ft 10.80	TUBULAR STEEL O/(in) 5.00 lb/ft 14.60	SIGN FRAME REQUIRED	REMARKS SHSM = STANDARD HIGHWAY SIGN & MARKING BOOK	SIGN DETAIL DETAIL IN SHSM	SIGN DETAIL DETAIL ON SHEET NUMBER	SIGN DETAIL STANDARD SHEET NUMBER
EB	MM 3.847, RT.	B		6	8		(1) TYPE II - 6" x 8" WHITE DELINEATOR																			INSTALL (1) DELINEATOR 201' EAST AND ACROSS FROM POLE # 88. PUT AT EAST END OF STONE WALL.		4	
WB	MM 3.857, LT.	E	W1-6	48	24			8.00								2.00		30		STUBS IN LEDGE						INSTALL NEW SIGN AND POSTS IN ISLAND LOCATED 170' WEST AND ACROSS FROM POLE # 575 / 2.	X		
WB	MM 3.884, LT.	F	W1-McR	30	30			6.25 6.25					X		X	1.00		15		MOVED 200' WEST						REPLACE EXISTING SIGN AND POST LOCATED 26' WEST AND ACROSS FROM POLE # 575 / 2.		11	
		F	W13-1	18	18			2.25					X													REPLACE EXISTING SIGN BELOW THE W1-1Mc L SIGN LOCATED 26' WEST AND ACROSS FROM POLE # 575 / 2.	X		
WB	MM 3.921, LT.	F	W1-1	30	30								X		X											REMOVE EXISTING SIGN AND POST LOCATED 170' EAST AND ACROSS FROM POLE # 575 / 2.			
EB	MM 4.082	A	W1-1	30	30								X		X											REMOVE EXISTING SIGN AND POST LOCATED 11' EAST OF POLE # 6.			
		A	W13-1	18	18								X													REMOVE EXISTING SIGN BELOW THE W1-1 SIGN LOCATED 11' EAST OF POLE # 6.			
EB	MM 4.137, LT.	A	W1-1	30	30			6.25								1.00		15								INSTALL NEW SIGN AND POST LOCATED 301' EAST OF POLE # 6.	X		
		A	W13-1	18	18			2.25																		INSTALL NEW SIGN BELOW THE W1-1 SIGN LOCATED 301' EAST OF POLE # 6.	X		
WB	MM 4.170, LT.	F	W1-6	48	24			8.00								2.00		30								INSTALL NEW SIGN AND POSTS 475' EAST AND ACROSS FROM POLE # 6.	X		
WB	MM 4.180, LT.	E	W1-6	48	24			8.00								2.00		30								INSTALL NEW SIGN AND POSTS 528' EAST AND ACROSS FROM POLE # 6.	X		
EB	MM 4.192, RT.	C	VD-024	72	10		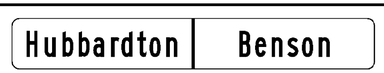	5.00								2.00		30								INSTALL NEW SIGN AND POSTS 590' EAST OF POLE # 6.		11	
										EA	EA	EA	EA 5	EA	EA 3		FT	FT 150	FT		LB	LB	LB	LB					
								SF ~~46.00~~ 52.25	SF	EA 5				EA 3		EA 10	FT ~~150~~ 119.75			EA	LB								

FINAL POST LENGTHS ARE TO BE DETERMINED IN THE FIELD. POST SIZES ARE COMPUTED BASED ON INFORMATION FURNISHED ON THE STANDARD SHEETS AND THE VTRANS "SIGN POST DESIGN GUIDE".

PROJECT NAME: STATEWIDE SOUTHWEST REGION
PROJECT NUMBER: STP HRRR(15)

FILE NAME: 12k024frm.dgn
PROJECT LEADER: JLS
DESIGNED BY: NLA
BENSON TRAFFIC SIGN SUMMARY SHEET 9

PLOT DATE: 06-AUG-2012
DRAWN BY: TDS
CHECKED BY: NLA
SHEET 30 OF 90