STATE OF VERMONT
AGENCY OF TRANSPORTATION

TRAFFIC SIGN SUMMARY SHEET 1

DANBY BROOK RD

DIRECTION	MILEMARKER, STATION, OR SIGN NUMBER	LOCATION	MANUAL ON UNIFORM TRAFFIC DEVICES OR STATE CODE	SIGN DIMENSIONS WIDTH	SIGN DIMENSIONS HEIGHT	SHEETING REMARKS	SIGN LEGEND	NEW SIGNS "A"	NEW SIGNS "B"	EXISTING SIGNS RETAIN	EXISTING SIGNS SALVAGE FROM	EXISTING SIGNS SALVAGE TO	EXISTING SIGNS REMOVE	EXISTING POST RETAIN	EXISTING POST REMOVE	NO. OF NEW POSTS	SQUARE STEEL (in) 1.75 lb/ft 1.88	SQUARE STEEL (in) 2.00 lb/ft 2.42	SQUARE STEEL (in) 2.50 lb/ft 3.35	TUBULAR STEEL O/(in) FOUNDATION	TUBULAR STEEL O/(in) 3.00 lb/ft 7.60	TUBULAR STEEL O/(in) 3.50 lb/ft 9.00	TUBULAR STEEL O/(in) 4.00 lb/ft 10.80	TUBULAR STEEL O/(in) 5.00 lb/ft 14.60	SIGN FRAME REQUIRED	REMARKS SHSM = STANDARD HIGHWAY SIGN & MARKING BOOK	SIGN DETAIL DETAIL IN SHSM	SIGN DETAIL DETAIL ON SHEET NUMBER	SIGN DETAIL STANDARD SHEET NUMBER
SB	MM 4.950, LT.	F	~~W1-4L~~ W1-4R	36	36			9.00								2.00		30								INSTALL NEW SIGN AT 586 FT NORTH OF AND ACROSS FROM A FIELD DRIVE.	X		
		F	W13-1P	18	18			2.25																		INSTALL NEW PLAQUE BELOW W1-5 R SIGN ON INSIDE POST.	X		
		F	W7-3aP	24	18			3.00																		INSTALL NEW PLAQUE BELOW W1-5 R SIGN ON OUTSIDE POST.	X		
SB	MM 4.870, LT.	F	W1-5L	30	30								X		X											REMOVE EXISTING POST AND SIGN AT 1008 FT NORTH OF AND ACROSS FROM A FIELD DRIVE.			
		F	W7-3aP	24	18								X													REMOVE EXISTING PLAQUE BELOW W1-5 R SIGN.			
		F	W1-10L	36	36			9.00								2.00		30								INSTALL NEW SIGN AND POST AT 1008 FT NORTH OF AND ACROSS FROM A FIELD DRIVE.	X		
		F	W16-8P	36	8			2.00																		INSTALL NEW STREET NAME BELOW W1-10 L SIGN ON THE SAME POST.		53	
SB	MM 4.848, LT.	F E	W1-8 W1-8	18 18	24 24			3.00 3.00								1.00		15								INSTALL NEW BACK-TO-BACK CHEVRON SIGNS ON SIGN BRACKET 142 FT SOUTH AND ACROSS FROM THE END OF SOUTHBOUND GUARDRAIL.	X X		
SB	MM 4.833, LT.	F E	W1-8 W1-8	18 18	24 24			3.00 3.00								1.00		15								INSTALL NEW BACK-TO-BACK CHEVRON SIGNS ON SIGN BRACKET 79 FT SOUTH AND ACROSS FROM THE END OF NORTHBOUND GUARDRAIL.	X X		
SB	MM 4.818, LT.	F	W1-6L	48	24			8.00								2.00		30								INSTALL NEW SIGN AND POSTS AT THE END OF NORTHBOUND GUARDRAIL.	X		
SB	MM 4.792, LT.	E	W1-6R	48	24			8.00								2.00		30								INSTALL A NEW SIGN AND POSTS AT THE SOUTHEAST CORNER OF BROOK RD AND KEELER RD.	X		
SB	MM 4.782, LT.	F	W1-6L	48	24		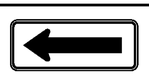	8.00								2.00		30								INSTALL NEW SIGN AND POSTS AT THE NORTHEAST CORNER OF BROOK ROAD AND TH 47 INTERSECTION.	X		
								SF 61.25	SF	EA 2	EA	EA	EA	EA 1	EA	EA 11	FT 165	FT	FT	EA	LB	LB	LB	LB				

FINAL POST LENGTHS ARE TO BE DETERMINED IN THE FIELD. POST SIZES ARE COMPUTED BASED ON INFORMATION FURNISHED ON THE STANDARD SHEETS AND THE VTRANS "SIGN POST DESIGN GUIDE".

PROJECT NAME: STATEWIDE SOUTHWEST REGION
PROJECT NUMBER: HES HSIP(6)

FILE NAME: I2k024frm.dgn (I2k042)
PROJECT LEADER: JLS
DESIGNED BY: NLA
DERBY TRAFFIC SIGN SUMMARY SHEET 1

PLOT DATE: 06-AUG-2012
DRAWN BY: TDS
CHECKED BY: NLA
SHEET 73 **OF** 90