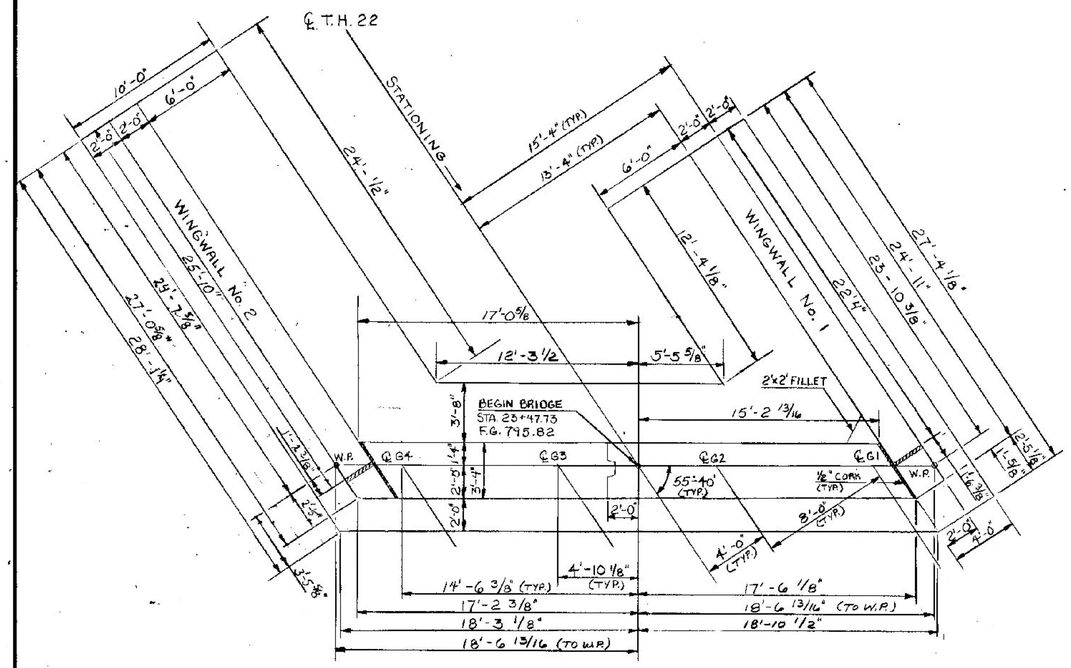

PLAN

SCALE: 1/4" = 1'-0"

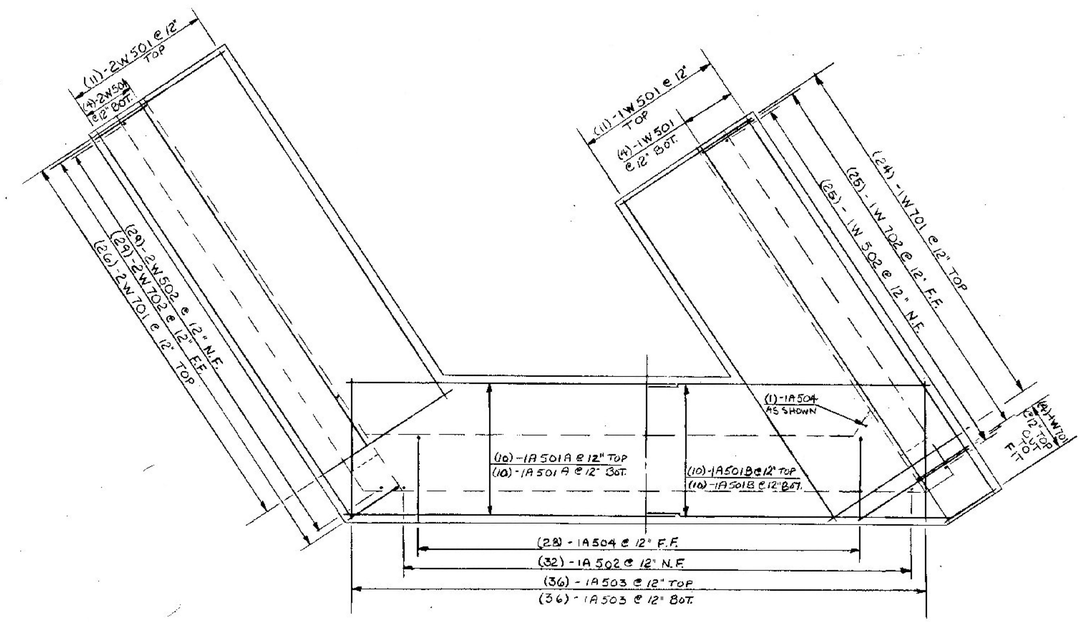

FOOTING REINFORCING PLAN

SCALE: 1/4" = 1'-0"

NOTES

1. FOR WINGWALL NO. 1 & NO. 2 DETAILS SEE SHEET
2. 4" Ø WEEPHOLES SHALL BE SPACED @ 10'-0 C.C. MAX. THEY SHALL BE PLACED 1'-0 ABOVE THE TOPS OF FOOTINGS AND SHALL SLOPE 1/4" PER FT. TO OUTSIDE OF ABUTMENT.
3. ALL CONCRETE IN ABUTMENTS TO BE CLASS B.

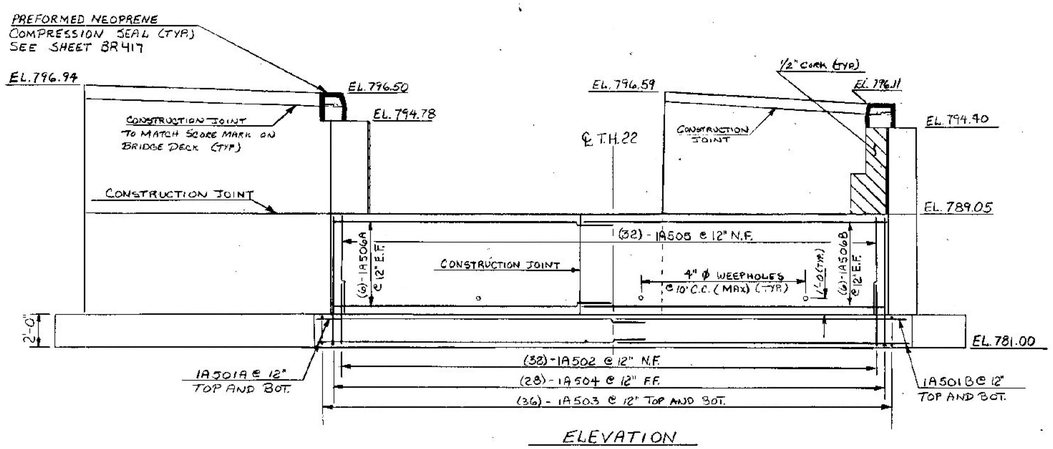

ELEVATION

SCALE: 1/4" = 1'-0

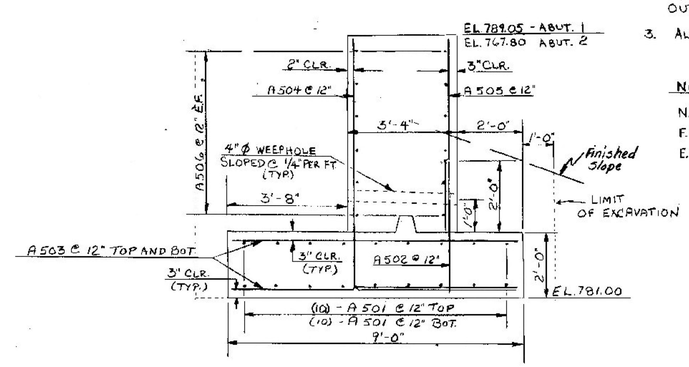

TYPICAL ABUTMENT SECTION

SCALE: 1/2" = 1'-0"

NOMENCLATURE

N.F. = NEAR FACE
F.F. = FAR FACE
E.F. = EACH FACE

CASTLETON-RUTLAND
BF MEMB (37)
SHEET 24 OF 28
BRIDGE D18
FOR REFERENCE ONLY

STATE OF VERMONT
AGENCY OF TRANSPORTATION

TOWN OF RUTLAND	Bridge No. 4
HIGHWAY NO. T.H. 22	Log Sta. / Surv. Sta. ℄ 887+80±
T.H. 22 OVER U.S. 4, EB & WB	
ABUTMENT NO. 1 DETAILS	
Designed by D. BURLEY	Drawn by M. EVANS 6/83
Checked by D. BURLEY date 7-83	Bridge Design Supervisor R.L. Ooley date 7-83
PROJECT W. RUTLAND - RUTLAND	PROJECT NO. F020-1(10)
Bridge Sheet No. BR 413	Sheet 200 of 457