

**PIKE INDUSTRIES, INC.**

STA 3+41.03 TH 26 =  
STA 4886+34.34 RR


STA 2+50.00  
BEGIN PROJECT

**PIKE INDUSTRIES, INC.**

STA 5+25.00  
END PROJECT

**TRILEASE, INC.**

**CHAMPLAIN PRECISION, INC.**

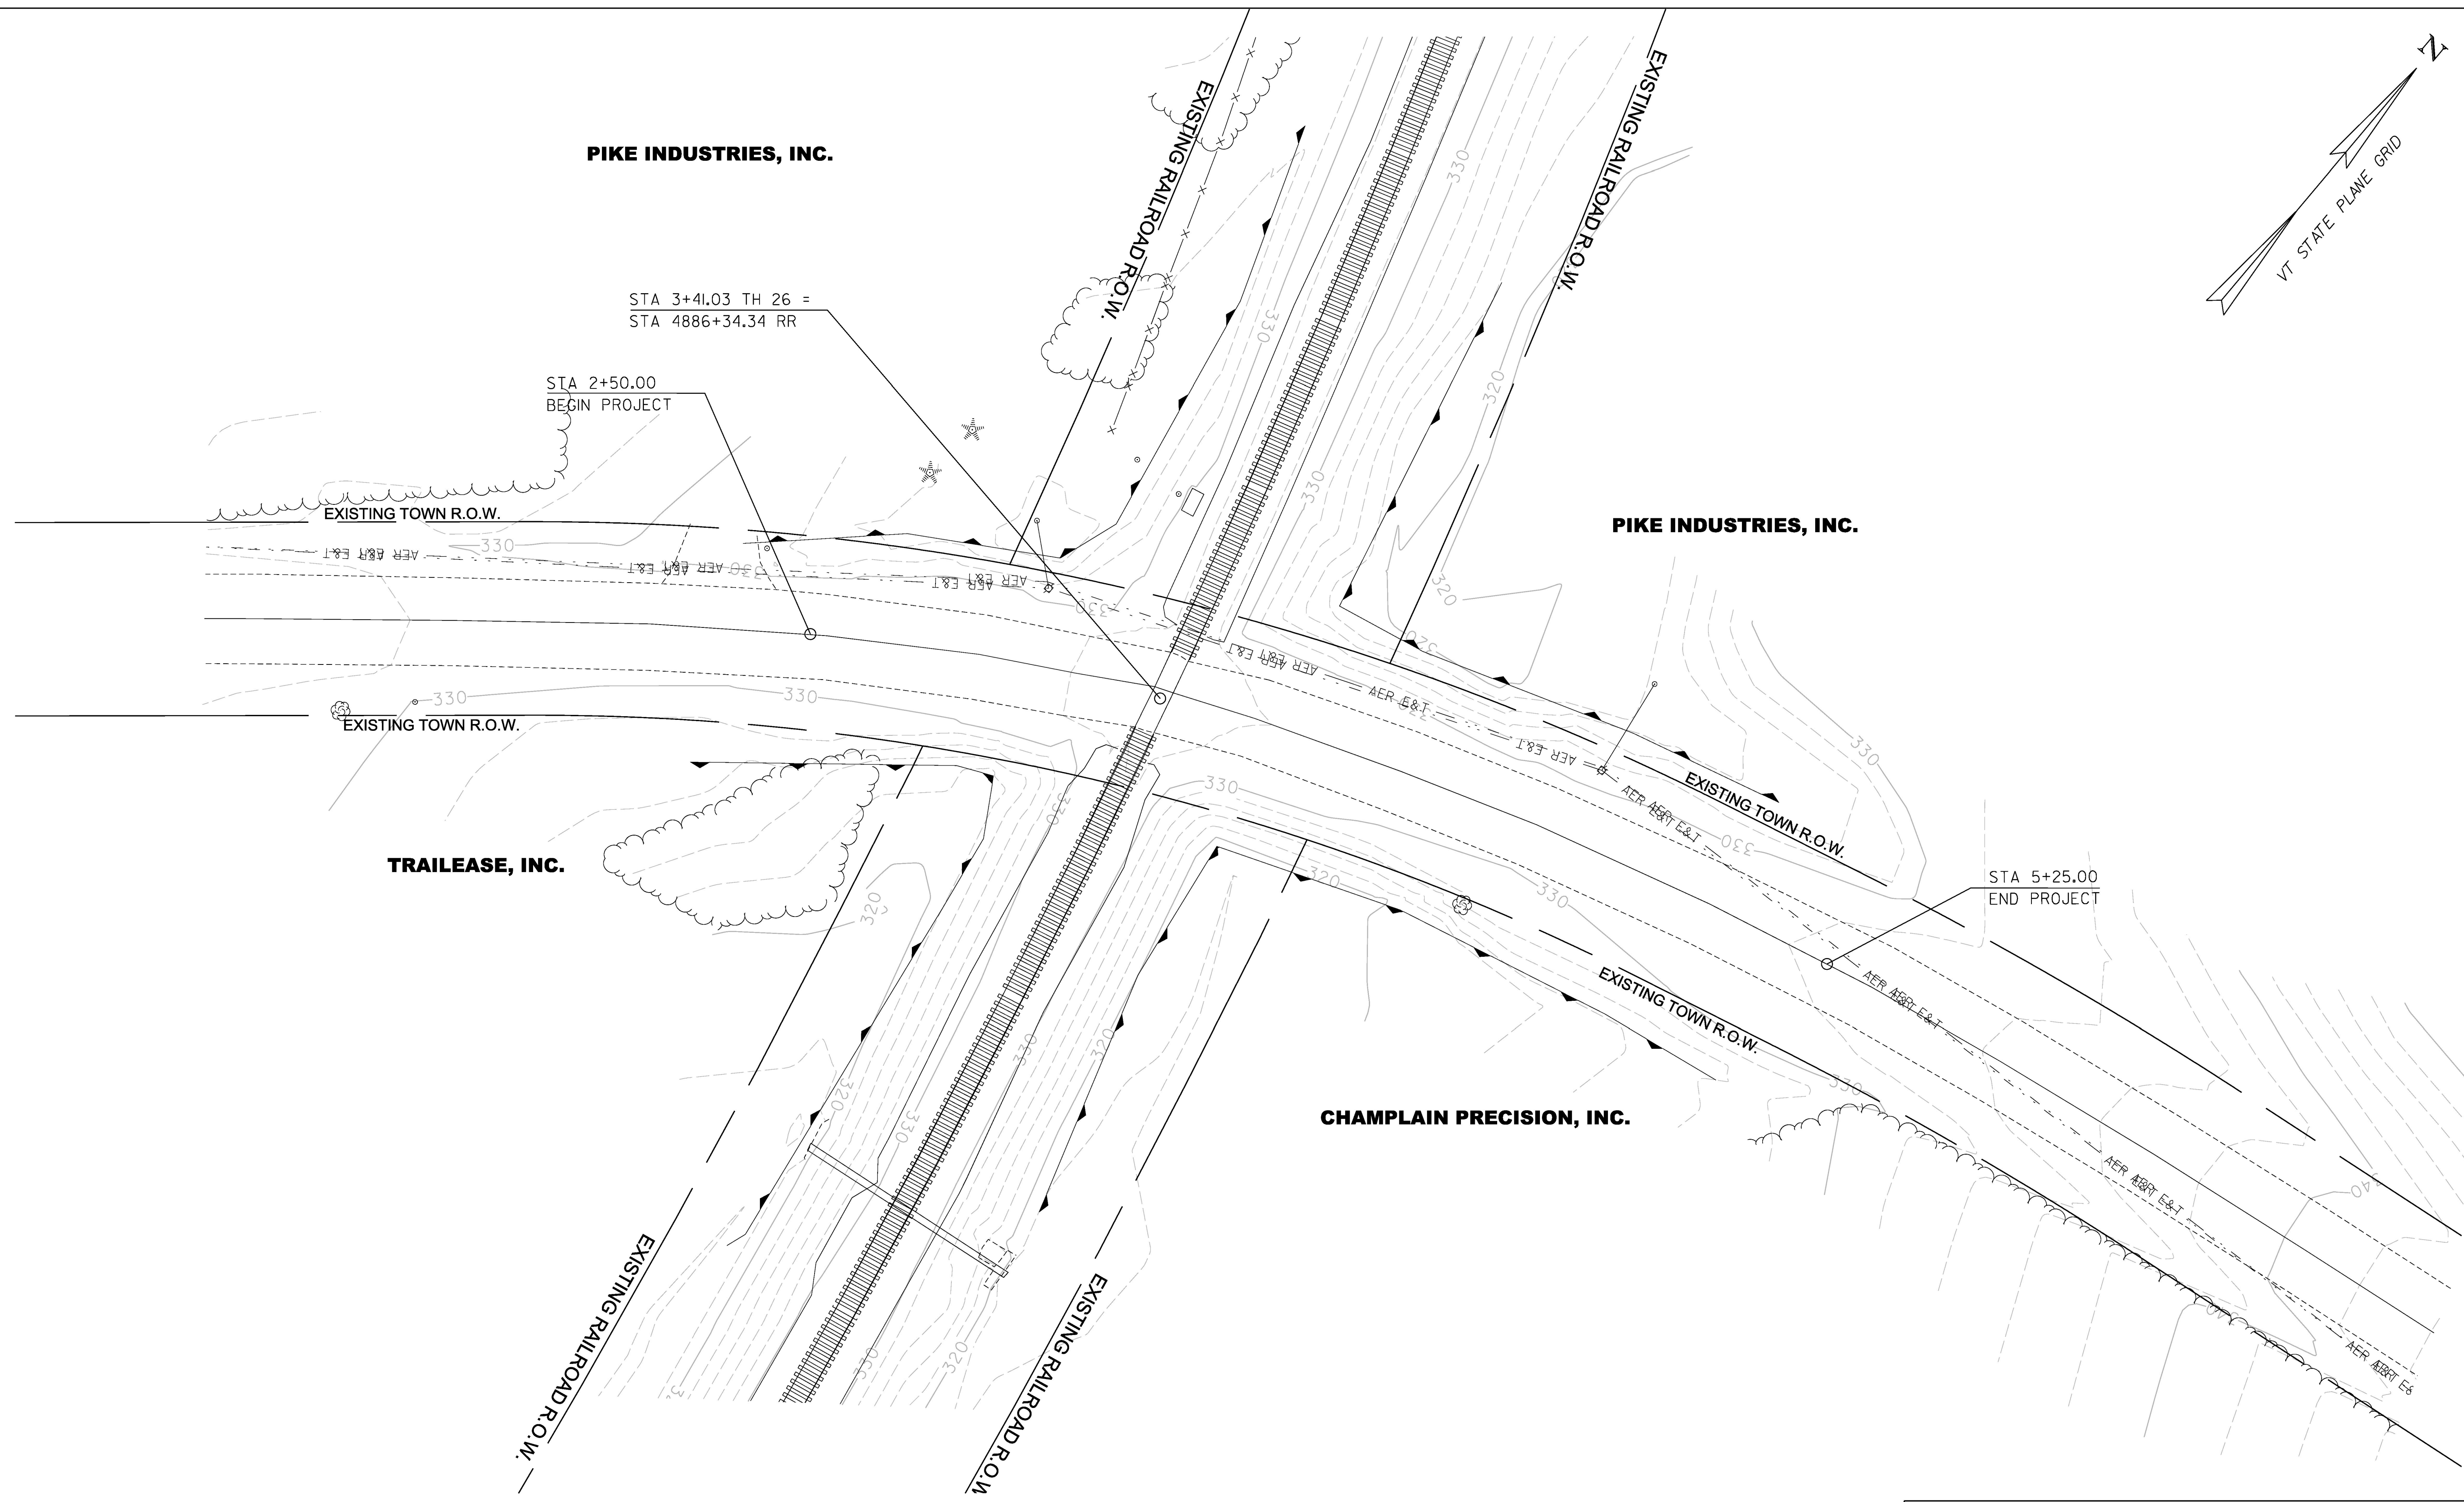

SCALE 1" = 20'-0"  
20 0 20



PROJECT NAME: NEW HAVEN	PLOT DATE: 2/15/2017
PROJECT NUMBER: STP 2035 (19)	DRAWN BY: W. TSE
FILE NAME: z13g606bdr_ero.dgn	CHECKED BY: R. O'BLENIS
PROJECT LEADER: R. O'BLENIS	SHEET 17 OF 42
DESIGNED BY: W. TSE	
EPSC EXISTING LAYOUT SHEET 1	