NOTES:

1. THE SITE PLAN SHOWN IS FOR ILLUSTRATIVE PURPOSES ONLY. IT WAS REPRODUCED FROM VHB PLAN AND ELEVATION PLAN (PROJECT #BF 0211 (32) DATED 8/22/2016.
2. THE WALLS ARE NOT DESIGNED FOR CONCENTRATED FLOW DIRECTED TO THE BACK OF THE WALL, INCLUDING BUT NOT LIMITED TO: SWALES, DOWNSPOUTS, ETC. GRADING SHALL DIRECT WATER AROUND THE ENDS OF THE WALLS WHEN POSSIBLE OR INTO COLLECTOR DRAINS.
3. THE APPROXIMATE LOCATION OF UTILITIES KNOWN TO EXIST AS SHOWN ON THE PLANS ARE BASED ON THE BEST INFORMATION AVAILABLE AT THE TIME OF PLAN PREPARATION.
4. THE CONTRACTOR SHALL VERIFY INVERTS OF PROPOSED AND EXISTING UTILITIES TO ENSURE THERE ARE NO CONFLICTS. THE ENGINEER SHALL BE CONTACTED IF CONFLICTS ARISE AND AN ALTERNATIVE DESIGN MAY BE REQUIRED.

LEGEND:

WALL LOCATION

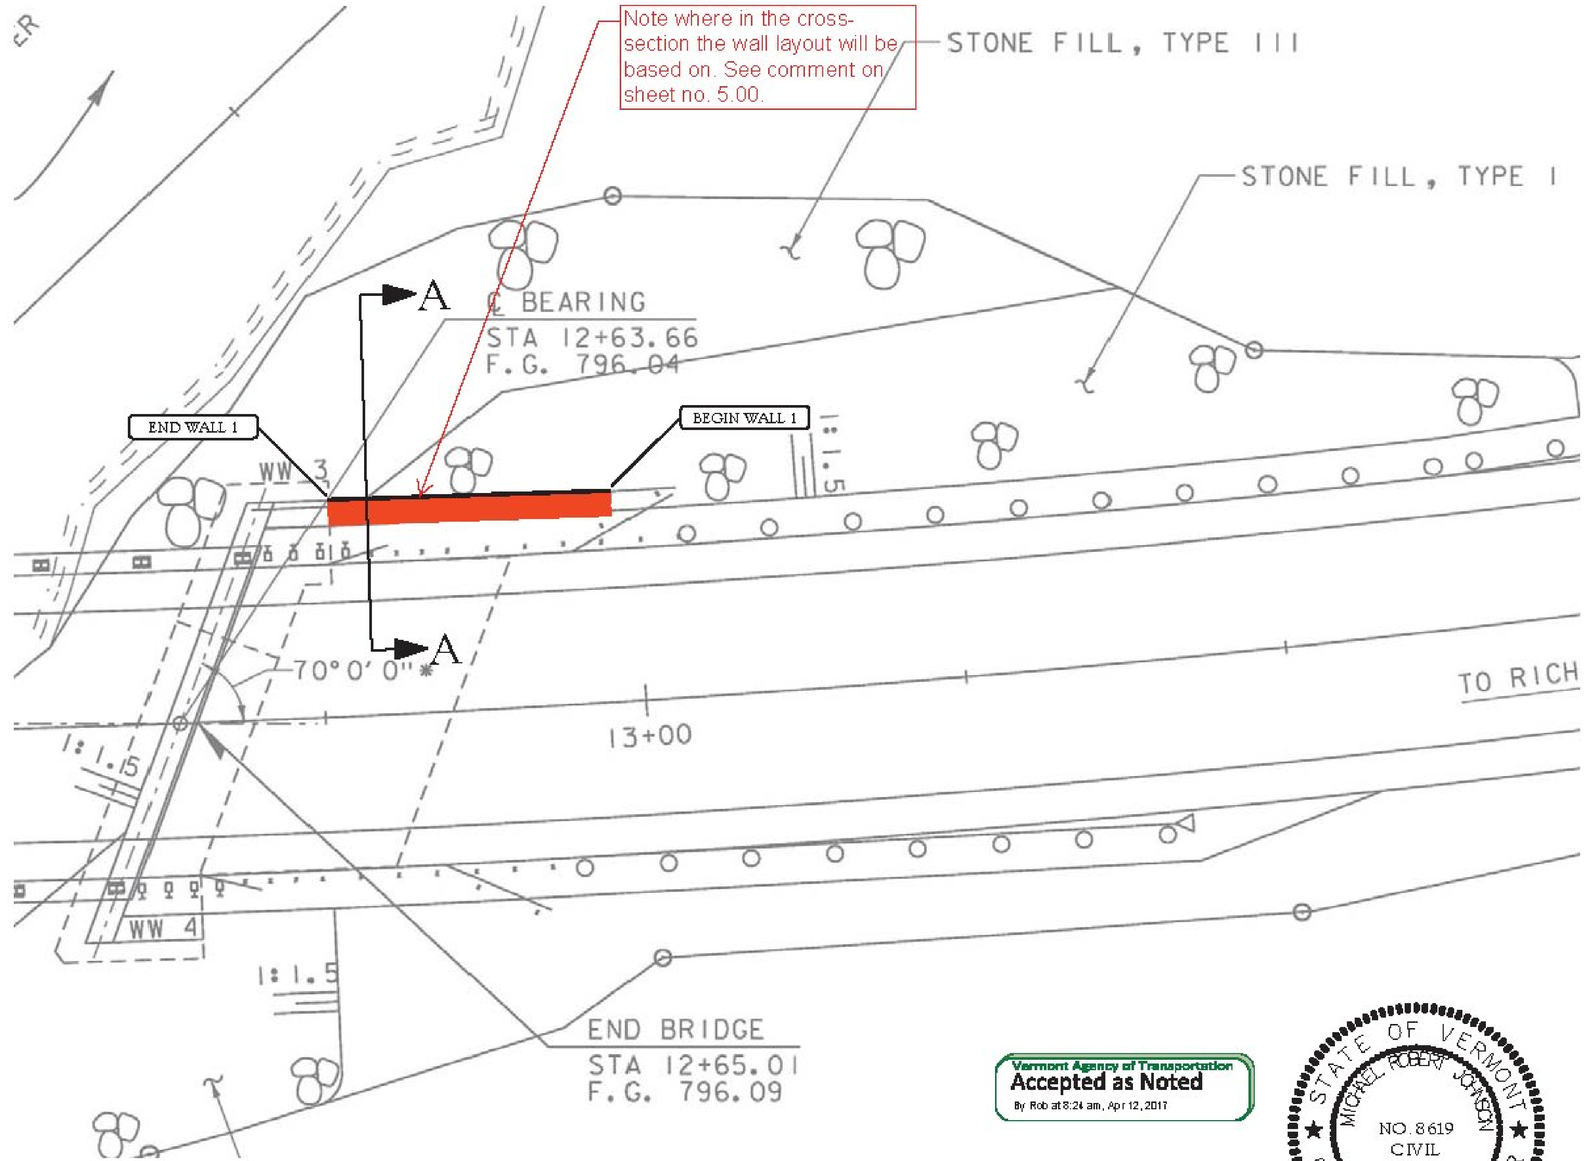

0 10 20 30

GRAPHIC SCALE IN FEET

Know what's below. Call before you dig.

Vermont Agency of Transportation
Accepted as Noted
By Rob at 8:24 am, Apr 12, 2017

STATE OF VERMONT
MICHAEL ROBERT JOHNSON
NO. 8619
CIVIL
PROFESSIONAL ENGINEER
LICENSED

MICHAEL R. JOHNSON, P.E. Date: 4/4/17

CIVIL DESIGN PROFESSIONALS

No.	Date	Revision	By
1	3/6/17	PER STATE COMMENTS	JBC
2	4/4/17	PER STATE COMMENTS	JBC
3			
4			
5			
6			

Designed By: JBC
Scale: 1" = 10'
Date: JAN 10, 2017

Project: HUNTINGTON BF 0211(32) HUNTINGTON, VERMONT

Title: SITE PLAN

Registration No.: 8619
Project No.: 16-1034
Sheet No.: 2.00

M:\40 34/4/2017 COPYRIGHT(c)2011-2016 BY CDP. DESIGNS FROM PROFESSIONALS. THIS DRAWING IS BEING FURNISHED FOR THIS SPECIFIC PROJECT ONLY. CONTAINED/OUTPUTS WITHOUT THE CONSENT OF CDP. DESIGNS FROM PROFESSIONALS IS PROHIBITED.