PART INFO		SHOP	BILL OF MATERIAL					JOB NO.	DRAWING NO.	REV.
TYPE	LINE	MARK	QTY	PARTS	DESCRIPTION	LENGTH FT	LENGTH INCHES	DESIGNER	QT	PROCUREMENT NOTES
					DIAPHRAGMS					
2	H		8	3DL	M 33X118	7	1 1/2		899	

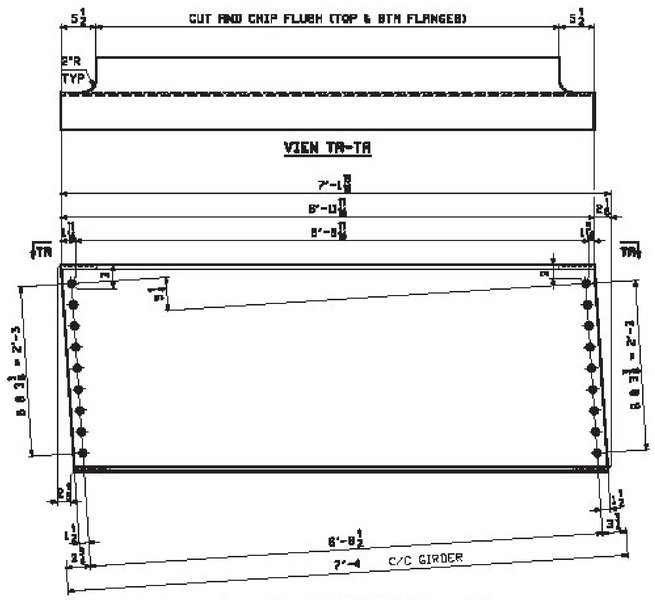

9 ~ INT. DIAPHRAMGS - 5D1
(LOOKING BACK-STATION)

NOTE:
FOR GENERAL NOTES SEE DRAWING GN1.

REV.	DATE	REMARKS	DWN	CHK	APVL	SHOP
0						

MATERIAL:	SURFACE PREP. & PAINT:	HOLES:	SHOP BOLTS:
M270-50W	SEE DWG GN1	15/16"Φ	NONE

DESCRIPTION: DIAPHRAGMS

CASCO BAY STEEL STRUCTURES, INC.
1 HALLIFAX AVE.
SOUTH PORTLAND, ME 04106
PHONE (207) 780-0782
FAX. (207) 780-0788
VERMONT 2001

STRUCTURE:	TH-1, FAS RT. 0211 / HUNTINGTON RIVER RURAL MAJOR COLLECTOR BRIDGE 8 COUNTY OF CHITTENDEN	DRAWN: JTB	DATE: 01/18
		CHKD: DBH	DATE: 01/18
LOCATION:	TOWN OF HUNTINGTON, VERMONT	JOB NO.	DWG NO.
PROJ NO.	STATE PROJ. BF-0211(32)	695-1	5
OWNER:	VERMONT AGENCY OF TRANSPORTATION		REV.

Vermont Agency of Transportation
RECEIVED
CK'D BY _____ OK'D BY Rob Young
February 16, 2017
RESUBMIT _____ Approved As Noted
BY Rob Young DATE 03/05/2017