STATE OF VERMONT
AGENCY OF TRANSPORTATION

TRAFFIC SIGN SUMMARY SHEET 2

DOVER
HANDLE ROAD

DIRECTION	MILEMARKER, STATION, OR SIGN NUMBER	LOCATION	MANUAL ON UNIFORM TRAFFIC DEVICES OR STATE CODE	SIGN DIMENSIONS WIDTH	SIGN DIMENSIONS HEIGHT	SHEETING REMARKS	SIGN LEGEND	NEW SIGNS "A"	NEW SIGNS "B"	EXISTING SIGNS RETAIN	EXISTING SIGNS SALVAGE FROM	EXISTING SIGNS SALVAGE TO	EXISTING SIGNS REMOVE	EXISTING POST RETAIN	EXISTING POST REMOVE	NO. OF NEW POSTS	SQUARE STEEL (in) 1.75 lb/ft 1.88	SQUARE STEEL (in) 2.00 lb/ft 2.42	SQUARE STEEL (in) 2.50 lb/ft 3.35	TUBULAR STEEL O/(in) FOUNDATION	TUBULAR STEEL O/(in) 3.00 lb/ft 7.60	TUBULAR STEEL O/(in) 3.50 lb/ft 9.00	TUBULAR STEEL O/(in) 4.00 lb/ft 10.80	TUBULAR STEEL O/(in) 5.00 lb/ft 14.60	SIGN FRAME REQUIRED	REMARKS SHSM = STANDARD HIGHWAY SIGN & MARKING BOOK	SIGN DETAIL: DETAIL IN SHSM	SIGN DETAIL: DETAIL ON SHEET NUMBER	SIGN DETAIL: STANDARD SHEET NUMBER
SB	MM 0.309 LT	F	W1-6R	48	24								X		X											REMOVE EXISTING LARGE RIGHT ARROW SIGN AND POSTS LOCATED 42' SOUTH OF POLE # 63/165981			
SB	MM 0.411 LT	F	TOWN SIGN	30	30								X		X											REMOVE EXISTING DANGEROUS CURVE AHEAD SIGN AND POST LOCATED 121' SOUTH OF POLE # 66/165988			
NB	MM 0.417 RT	A	R2-1	24	30			5.00					X		X	1		~~15~~ 12.75								REPLACE EXISTING SPEED LIMIT SIGN AND POST LOCATED 90' SOUTH OF AND ACROSS FROM POLE # 66/165988 (MM .434)	X		
SB	MM 0.417 LT	F	R2-1	24	30			5.00					X		X	1		~~15~~ 13.25								REPLACE EXISTING SPEED LIMIT SIGN AND POST LOCATED 90' SOUTH OF POLE # 66/165988 (MM .434)	X		
SB	MM 0.908 LT	F	R2-1	24	30			5.00					X		X	1		~~15~~ 13								REPLACE EXISTING SPEED LIMIT SIGN AND POST LOCATED 21' NORTH OF POLE # 66/165988 (MM .904)	X		
NB	MM 0.917 RT	A	R2-1	24	30			5.00					~~X~~ 2		~~X~~ 2	1		~~15~~ 13								REPLACE EXISTING SPEED LIMIT SIGN AND POST LOCATED 69' NORTH OF AND ACROSS FROM POLE # 66/165988 (MM 0.904)	X		
NB	MM 1.447 RT	A	R2-1	24	30			5.00					X		X	1		~~15~~ 13								REPLACE EXISTING SPEED LIMIT SIGN AND POST LOCATED 48' SOUTH OF AND ACROSS FROM POLE # 19/GMP/25	X		
SB	MM 1.447 LT	F	R2-1	24	30			5.00					X		X	1		~~15~~ 13.5								REPLACE EXISTING SPEED LIMIT SIGN AND POST LOCATED 48' SOUTH OF POLE # 19/GMP/25	X		
SB	MM 1.704 LT	E F	D3-1	42	12		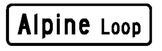	3.50					X		X	1		~~15~~ 11.5								REPLACE EXISTING STREET NAME SIGN AND POST LOCATED 32' NORTH OF AND ACROSS FROM POLE # 8-5-3-27/NET/12/GMP/12		10	
SB	MM 1.770 LT	E F	D3-1	42	12			3.50								1		~~15~~ 11								INSTALL A NEW STREET NAME SIGN AND POST LOCATED 100' SOUTH OF AND ACROSS FROM POLE # NET/9/GMP/9		10	
SB	MM 1.903 LT	F	W11-2	30	30								X		X											REMOVE EXISTING PEDESTRIAN SYMBOL SIGN AND POST LOCATED 58' SOUTH OF AND ACROSS FROM POLE # 8-5-3/5/GMP			
SB	MM 1.943 LT	F	R2-1	24	30			5.00					X		X	1		~~15~~ 13.75								REPLACE EXISTING SPEED LIMIT SIGN AND POST LOCATED 153' NORTH OF AND ACROSS FROM POLE # 8-5-3/5/GMP	X		
										EA	EA	EA	EA ~~11~~ 12	EA	EA ~~11~~ 12		FT	FT 135	FT		LB	LB	LB	LB					
								SF 42.00	SF	EA 11				EA 11		EA 9	FT ~~135~~ 114.75			EA	LB								

FINAL POST LENGTHS ARE TO BE DETERMINED IN THE FIELD. POST SIZES ARE COMPUTED BASED ON INFORMATION FURNISHED ON THE STANDARD SHEETS AND THE VTRANS "SIGN POST DESIGN GUIDE".

PROJECT NAME: STATEWIDE SOUTHEAST REGION
PROJECT NUMBER: STP HRRR(18)

FILE NAME: 13K034wrk.dgn
PROJECT LEADER: P. COBURN
DESIGNED BY: N. PATTIS
DOVER TRAFFIC SIGN SUMMARY SHEET 2

PLOT DATE: 1/3/2014
DRAWN BY: N. PATTIS
CHECKED BY: B. GROSE
SHEET 13 OF 34