STATE OF VERMONT
AGENCY OF TRANSPORTATION

TRAFFIC SIGN SUMMARY SHEET 4

DOVER
HANDLE ROAD

DIRECTION	MILEMARKER, STATION, OR SIGN NUMBER	LOCATION	MANUAL ON UNIFORM TRAFFIC DEVICES OR STATE CODE	SIGN DIMENSIONS WIDTH	SIGN DIMENSIONS HEIGHT	SHEETING REMARKS	SIGN LEGEND	NEW SIGNS "A"	NEW SIGNS "B"	EXISTING SIGNS RETAIN	EXISTING SIGNS SALVAGE FROM	EXISTING SIGNS SALVAGE TO	EXISTING SIGNS REMOVE	EXISTING POST RETAIN	EXISTING POST REMOVE	NO. OF NEW POSTS	SQUARE STEEL (in) 1.75 lb/ft 1.88	SQUARE STEEL (in) 2.00 lb/ft 2.42	SQUARE STEEL (in) 2.50 lb/ft 3.35	TUBULAR STEEL O/(in) FOUNDATION	TUBULAR STEEL O/(in) 3.00 lb/ft 7.60	TUBULAR STEEL O/(in) 3.50 lb/ft 9.00	TUBULAR STEEL O/(in) 4.00 lb/ft 10.80	TUBULAR STEEL O/(in) 5.00 lb/ft 14.60	SIGN FRAME REQUIRED	REMARKS SHSM = STANDARD HIGHWAY SIGN & MARKING BOOK	SIGN DETAIL DETAIL IN SHSM	SIGN DETAIL DETAIL ON SHEET NUMBER	SIGN DETAIL STANDARD SHEET NUMBER
NB	MM 2.056 RT	A	W11-2	30	30	FYG		6.25								1		~~15~~ 14								INSTALL A NEW PEDESTRIAN SYMBOL SIGN AND POST LOCATED 21' NORTH OF POLE # CC/123802/17	X		
NB	NB 2.056 RT	A	W16-7P	24	12	FYG		2.00																		INSTALL A NEW DIAGONAL ARROW PLAQUE BENEATH AND ON THE SAME POST AS THE NEW W11-2 SIGN LOCATED 21' NORTH OF POLE # CC/123802/17	X		
SB	SB 2.056 LT	F	W11-2	30	30	FYG		6.25								1		~~15~~ 14								INSTALL A NEW PEDESTRIAN SYMBOL SIGN AND POST LOCATED 21' NORTH OF AND ACROSS FROM POLE # CC/123802/17	X		
SB	MM 2.056 LT	F	W16-7P	24	12	FYG		2.00																		INSTALL A NEW DIAGONAL ARROW PLAQUE BENEATH AND ON THE SAME POST AS THE NEW W11-2 SIGN LOCATED 21' NORTH OF AND ACROSS FROM POLE # CC/123802/ 17	X		
NB	MM 2.272 RT	A	R1-5A	36	48								~~X~~		~~X~~											REMOVE EXISTING YIELD TO PEDESTRIANS SIGN AND POST LOCATED 275' SOUTH OF POLE # 123811/8-5/17			
SB	MM 2.320 LT	F	R1-5A	36	48								X		X											REMOVE EXISTING YIELD TO PEDESTRIANS SIGN AND POST LOCATED 21' SOUTH OF AND ACROSS FROM POLE # 123811/ 8-5/17			
SB	MM 2.320 LT	F	W11-15	30	30	FYG		6.25								1		15								INSTALL A NEW BICYCLE/PEDESTRIAN WARNING SIGN AND POST LOCATED 21' SOUTH OF AND ACROSS FROM POLE # 123811/8-5/17	X		
SB	MM 2.320 LT	F	W16-1P	18	24	FYG		~~3.0~~ ~~2.25~~																		INSTALL A NEW SHARE THE ROAD PLAQUE BENEATH AND ON THE SAME POST AS THE W11-15 SIGN LOCATED 21' SOUTH OF AND ACROSS FROM POLE # 123811/8-5/17	X		
NB	MM 2.327 LT	A	W11-5	30	30	FYG		6.25								1		15								INSTALL A NEW BICYCLE/PEDESTRIAN WARNING SIGN AND POST LOCATED 16' NORTH OF AND ACROSS FROM POLE # 123811/8-5/17	X		
NB	MM 2.327 LT	A	W16-1P	18	24	FYG		~~3.0~~ ~~2.25~~																		INSTALL A NEW SHARE THE ROAD PLAQUE BENEATH AND ON THE SAME POST AS THE W11-15 SIGN LOCATED 16' NORTH OF AND ACROSS FROM POLE # 123811/8-5/17	X		
SB	MM 2.327 LT	E F	D3-1	48	12			4.00								2		10.5 ~~30~~ 10.75								INSTALL A NEW STREET NAME SIGN ON TWO NEW POSTS LOCATED 16' NORTH OF AND ACROSS FROM POLE #123811/8-5/17		10	
SB	MM 2.327 LT	H	R2-1	30	30			6.25			2.320 LT		X		X	1		~~15~~ 12.25								REPLACE EXISTING STOP SIGN AND POST LOCATED 16' NORTH OF AND ACROSS FROM POLE # 123811/8-5/17	X		
SB	MM 2.337 LT	E F	D3-1	XX	XX		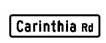						X		X											REMOVE EXISTING STREET NAME SIGN AND POST LOCATED 69' NORTH OF AND ACROSS FROM POLE # 123811/8-5/17			
										EA	EA	EA	EA ~~4~~ 3	EA	EA ~~4~~ 3			FT 105				LB	LB	LB	LB					
								SF ~~43.75~~ 45.25	SF	EA 4				EA 4		EA 7		FT ~~105~~ 91.50		EA	LB									

FINAL POST LENGTHS ARE TO BE DETERMINED IN THE FIELD. POST SIZES ARE COMPUTED BASED ON INFORMATION FURNISHED ON THE STANDARD SHEETS AND THE VTRANS "SIGN POST DESIGN GUIDE".

PROJECT NAME: STATEWIDE SOUTHEAST REGION
PROJECT NUMBER: STP HRRR(18)

FILE NAME: 13K034wrk.dgn
PROJECT LEADER: P. COBURN
DESIGNED BY: N. PATTIS
DOVER TRAFFIC SIGN SUMMARY SHEET 4

PLOT DATE: 1/3/2014
DRAWN BY: N. PATTIS
CHECKED BY: B. GROSE
SHEET 15 OF 34